


FILED
 GREENVILLE CO. S. C.
 AUG 24 10 48 AM '83
 DONNIE S. WARRSLEY
 R.M.C.

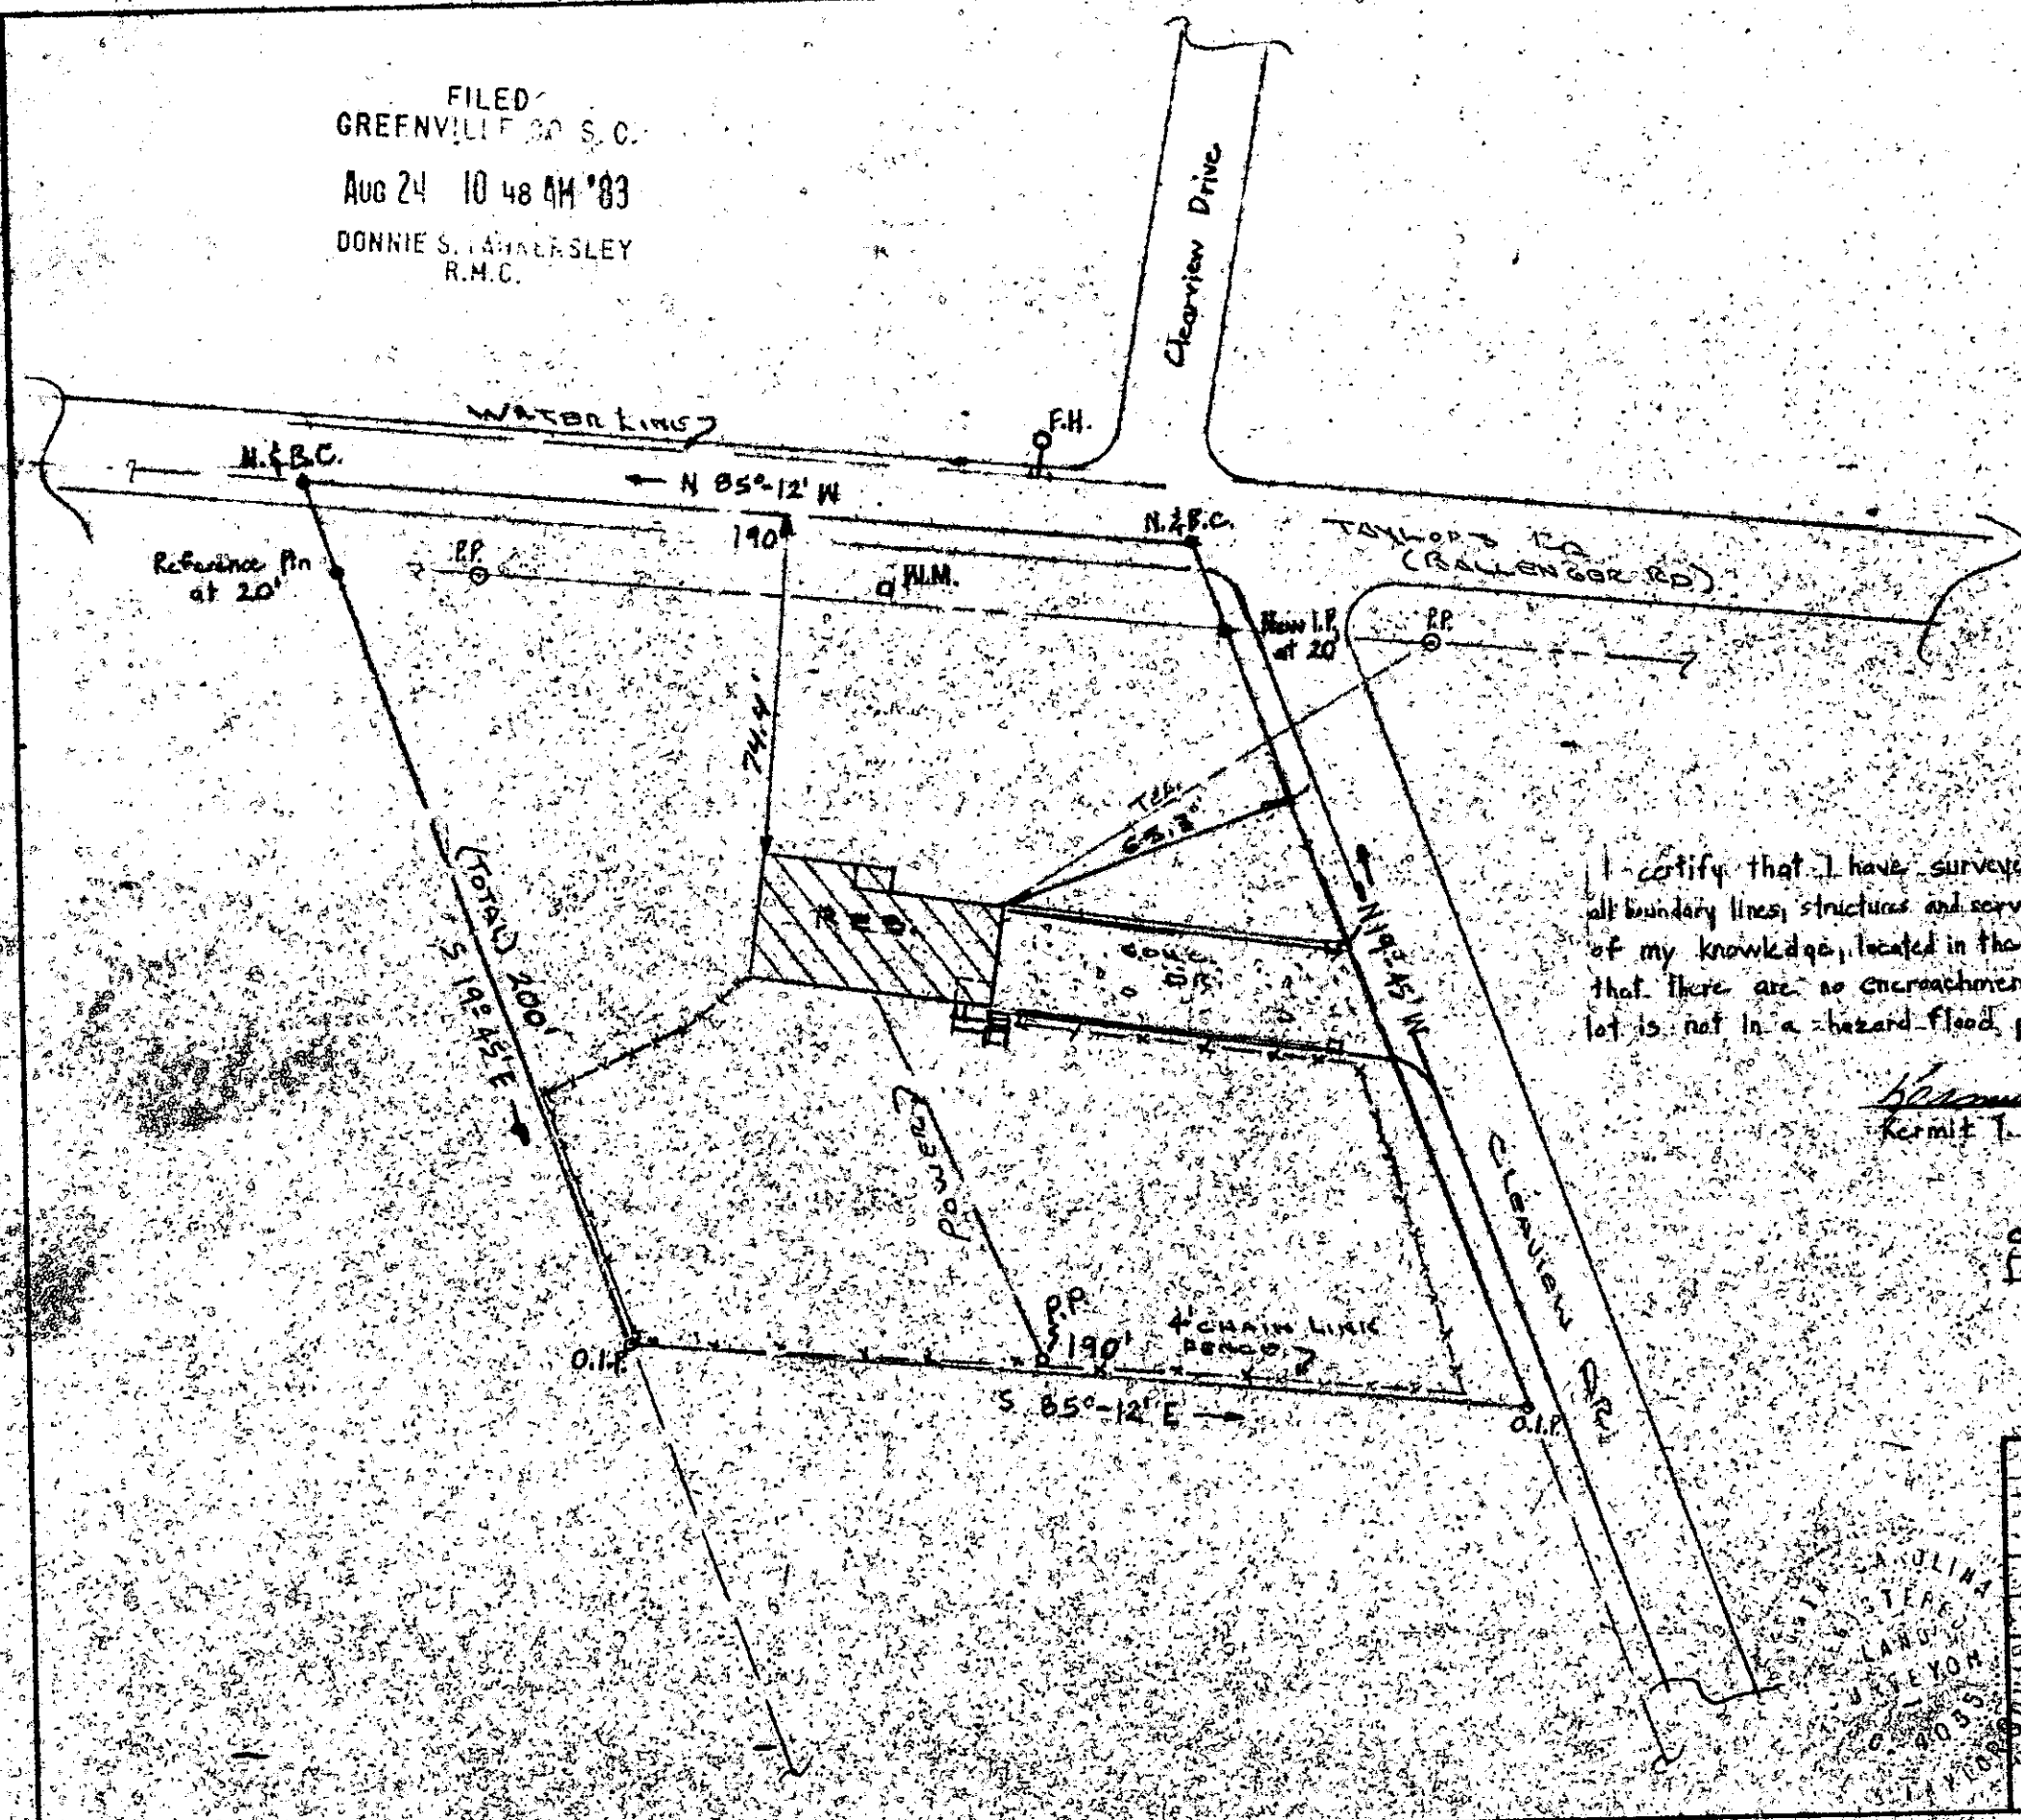


I certify that I have surveyed this lot and that all boundary lines, structures and services are, to the best of my knowledge, located in the field as here shown, that there are no encroachments, and that this lot is not in a hazard flood plain.

Kermit T. Gould
 Kermit T. Gould / SC RLS 4035

AUG 24 1983

19-X-42

6459

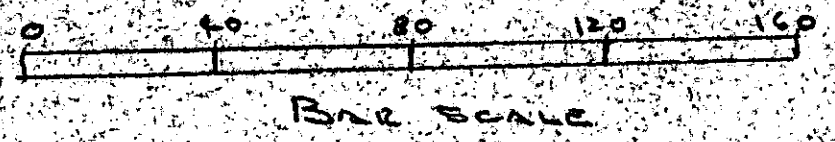

| | | | |
|---|-------------|------------------------|----------------------------|
| PROPERTY OF | | FRANK MCELRATH | |
| SCALE: 1"=40' | APPROVED BY | DRAWN BY K. Gould, JR. | |
| DATE: 8-15-83 | Location | | SOI TAYLOR'S RD GREENVILLE |
| Downwood Ac Subdivision, O'Neal Township } Greenville County, near Greer, SC | | Reference | |
| [Plot Book "J", Page 452] [Reel Vol. 1052, Page 512] | | DRAWING NUMBER | |