

I HEREBY CERTIFY THAT THE MEASUREMENTS AS SHOWN ARE CORRECT AND THERE ARE NO ENCHROACHMENTS OR PROJECTIONS OTHER THAN SHOWN.

THE PROPERTY AND BUILDINGS SHOWN ON THIS PLAT ARE NOT IN A FLOOD HAZARD AREA.

FILED  
GREENVILLE CO. S.C.  
SEP 16 2 14 PM '83  
DONNIE S. JAMESLEY  
R.M.C.

PLAT OF PROPERTY OF  
JOHN W. ALEXANDER  
JULIANA H. ALEXANDER

THE ABOVE PROPERTY IS LOCATED APPROX. 1/4 OF A MILE NORTH OF THE INTERSECTION OF HYW NO. 199  
HYW NO. 250  
GREENVILLE COUNTY  
SOUTH CAROLINA

*T. Craig Keith*  
T. CRAIG KEITH REG. L.S. NO. 1712


23 AUG 83

REF PLAT: RB. BRUCE  
JUL 64 3B-P6/7  
APR 65 3J-P81


9-X-66

SEP 16 1983

PARTY CHIEF  
FRANK DUNCAN

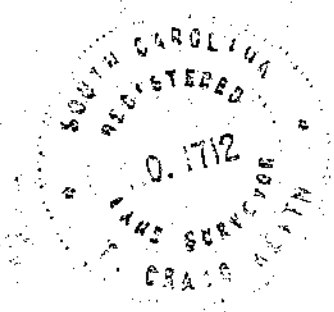

SCALE 1" = 50'

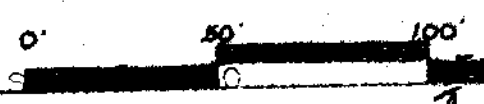

T.M.