
AF 10755A

This is to certify that on August 24, 1933, I surveyed the property shown on this plat known as Lot 62 on Plat of Jamestowne II, recorded in the RMC Office of Greenville County in Plat Book **9W** on Page **33** and that the property lines, walls, and buildings are as shown hereon; that the building located on said lot does not encroach or project on adjacent streets or property, and that no adjacent walls or buildings encroach or project on said premises, and that no utility lines cross this property except as shown hereon. this property is not located in a designated

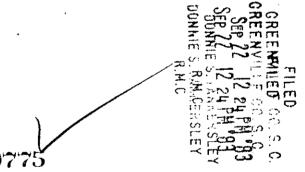

STATE OF SOUTH CAROLINA

FREELAND & ASSOCIATES Engineers • Land Surveyors

GREENVILLE, S.C.

JRVEY O.G.	
RAWN K.E.G.	
HECK B.R.	
ALE /"-20	
ATE 8-26-83	
NG. NO. 9637	

MICROFILMED