
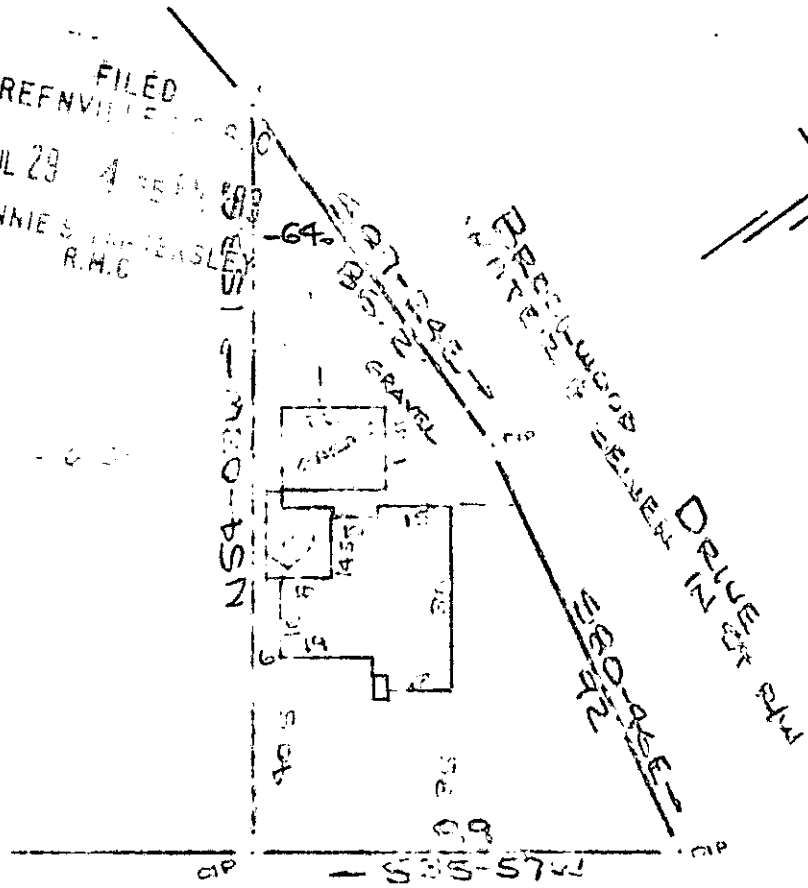


MICROFILMED

FILED
GREENVILLE
JUL 29 4 38 PM '83
R.H.C.

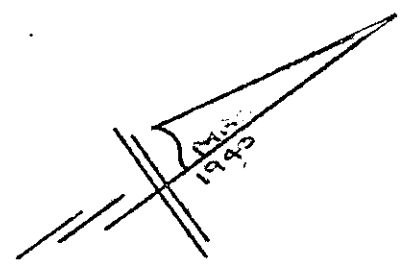


Note: Improvements on this lot are not in a flood hazard area.

MELVILLE AVENUE
WATER & SEWER IN ST RW

PROPERTY OF
DAVID L. STOVER & NELL P. STOVER
GREENVILLE, S.C.

26 JULY 1983


JUL 29 1983

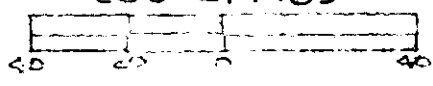

3472



✓ 9-Y-3

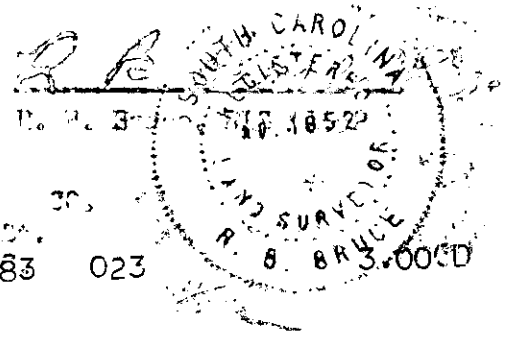

GREENVILLE, S.C. 29601
JUL 29 1983 023