


PROPERTY OF  
**HARVEST LANE TOWNHOMES**  
 A LIMITED PARTNERSHIP  
 GREENVILLE COUNTY, S.C.

FILED  
 GREENVILLE CO. S.C.  
 AUG 1 1 35 PM '83  
 DONNIE S. TANKERSLEY  
 R.M.C.

Scale 1" = 40' June, 1983

This is to certify that on the 29th day of June, 1983, we surveyed the property shown on this plat being known as Lot 24 on plat of Schwiars at Cleveland, recorded in plat book 7-X, page 20, Office of R.M.C., Greenville County, S.C.; and that the property lines, walls and buildings are as shown hereon; that the buildings located on said lot do not encroach or project on adjacent streets or property; and that no adjacent buildings or walls encroach or project on said premises; and from information from Greenville County, this structure is not in a designated flood area.

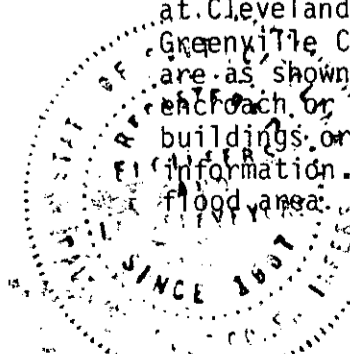

3659  
 9-2-10

*R.W. Dalton*  
 DALTON & NEVES CO., ENGINEERS