


This is to certify that on July 29, 1983, I surveyed the property shown on this plat, known as Lot 71 on the plat of Northwood (Sec. 1), recorded in the RMC Office of Greenville County in Plat Book 7X on page 98 and that the property lines, walls and buildings are as shown hereon; that the building located on said lot does not encroach or project on adjacent streets or property and that no adjacent walls or buildings encroach or project on said premises, and that no utility lines cross this property except as shown hereon. This property is not located in a designated flood hazard area.

James R. Freeland
James R. Freeland
RLS & PE 4781

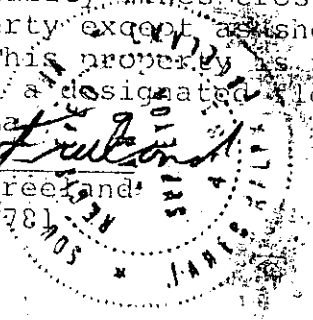

Note: 5' drainage & utility easement each side all side & rear lot lines unless otherwise noted.

FILED
GREENVILLE CO. S.C.
AUG 2 3 37 PM '83
DONNIE S. TANKERSLEY
R.M.C.
WOODVIEW DRIVE



9-y-23

3902 ✓



**STATE OF SOUTH CAROLINA
GREENVILLE COUNTY**

NORTH WOOD
SEC. 1 ; LOT 71
PROPERTY OF
RICHARD A. FAMILIA
SARA E. FAMILIA

FREELAND & ASSOCIATES
Engineers • Land Surveyors

GREENVILLE, S.C.

SURVEY	H.B.
DRAWN	K.E.G.
CHECK	RP
SCALE	1" = 40'
DATE	7-29-83
DWG. NO.	9459

2 AUG 2 83 1370

THE PRINT MACHINE, INC. 3.00CI