

MICROFILMED

3.0001
2 AU 8 83 M08

-N/E H.C. & C. POWERS-

-N/E C.C. JAMES-


N 30-25 E
P.O.P.

S 2-44 W

S 85-15 W
187.2'

-N/E R.S. & JANE ABRAHAM-

Note: Improvements
this lot are not in
Good Record etc.

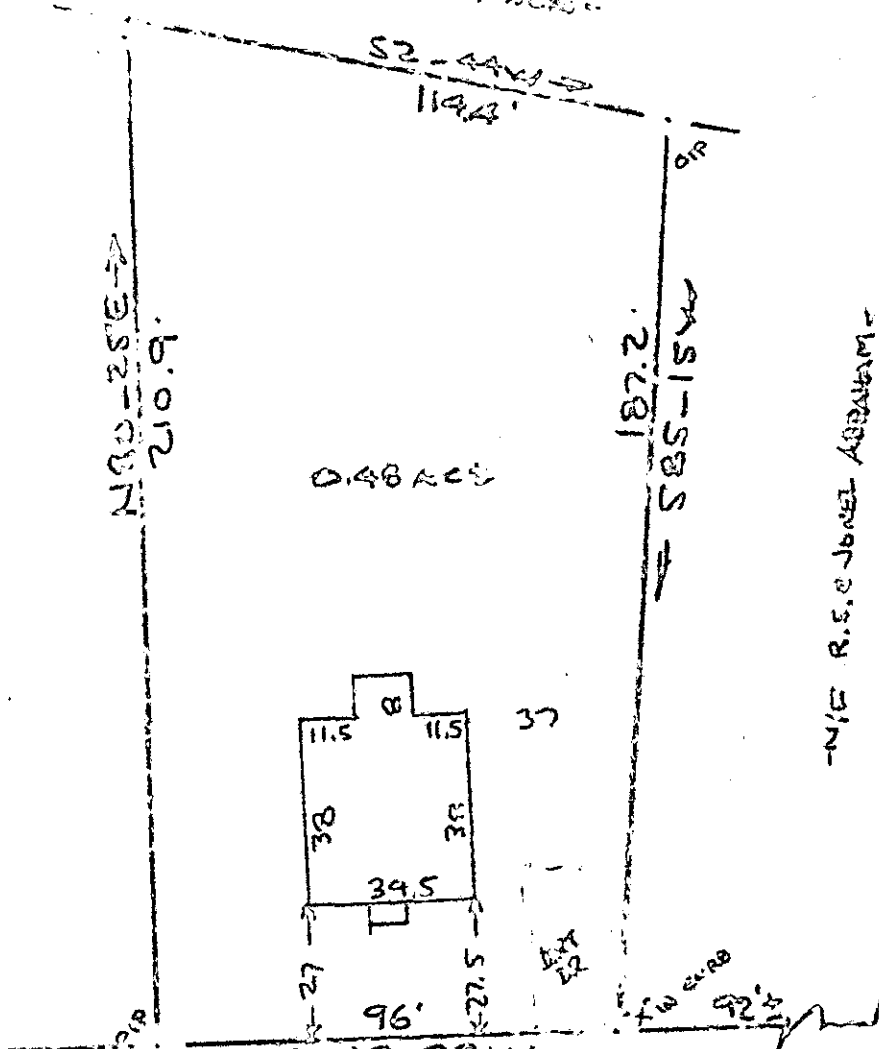

FILED
GREENVILLE CO. S.C.
AUG 8 9 40 AM '83
DONNIE S. TANKERSLEY
R.M.C.

TRYON ST.
WATER & SEWER IN S/S RIW

PROPERTY OF
JACKIE LANE GATTONSON
GREEN, S.C. - GREENVILLE, SO
20 AUG 0 1983 40

This is to certify that on the 20th day of August, 1983, I surveyed the property
described in the plat, being located on the property of JACKIE LANE GATTONSON and
recorded in the REC OFFICE Greenville County, S. C., in Plat Book " " of
Page " " and that the property lines, walls and buildings are as shown hereon
and that the walls and buildings located on said lot do not encroach or project
or adjoin or project or prevent, and that no adjacent walls or buildings, either
or project on said premises, and no water lines cross this property, except as
shown hereon.

4509

AUG 8 1983

R. B. [Signature]
REGISTERED
10.1052
SOUTH CAROLINA
LAND SURVEYOR
AUG 8 1983

9-y-44

CAROLINA SURVEYING CO.
112 Holly St.
Greenville, S.C. 29601