


FILED  
GREENVILLE, S.C.  
AUG 8 2 07 PM '83  
DONNIE S. LAMBERSLEY  
R.M.C.

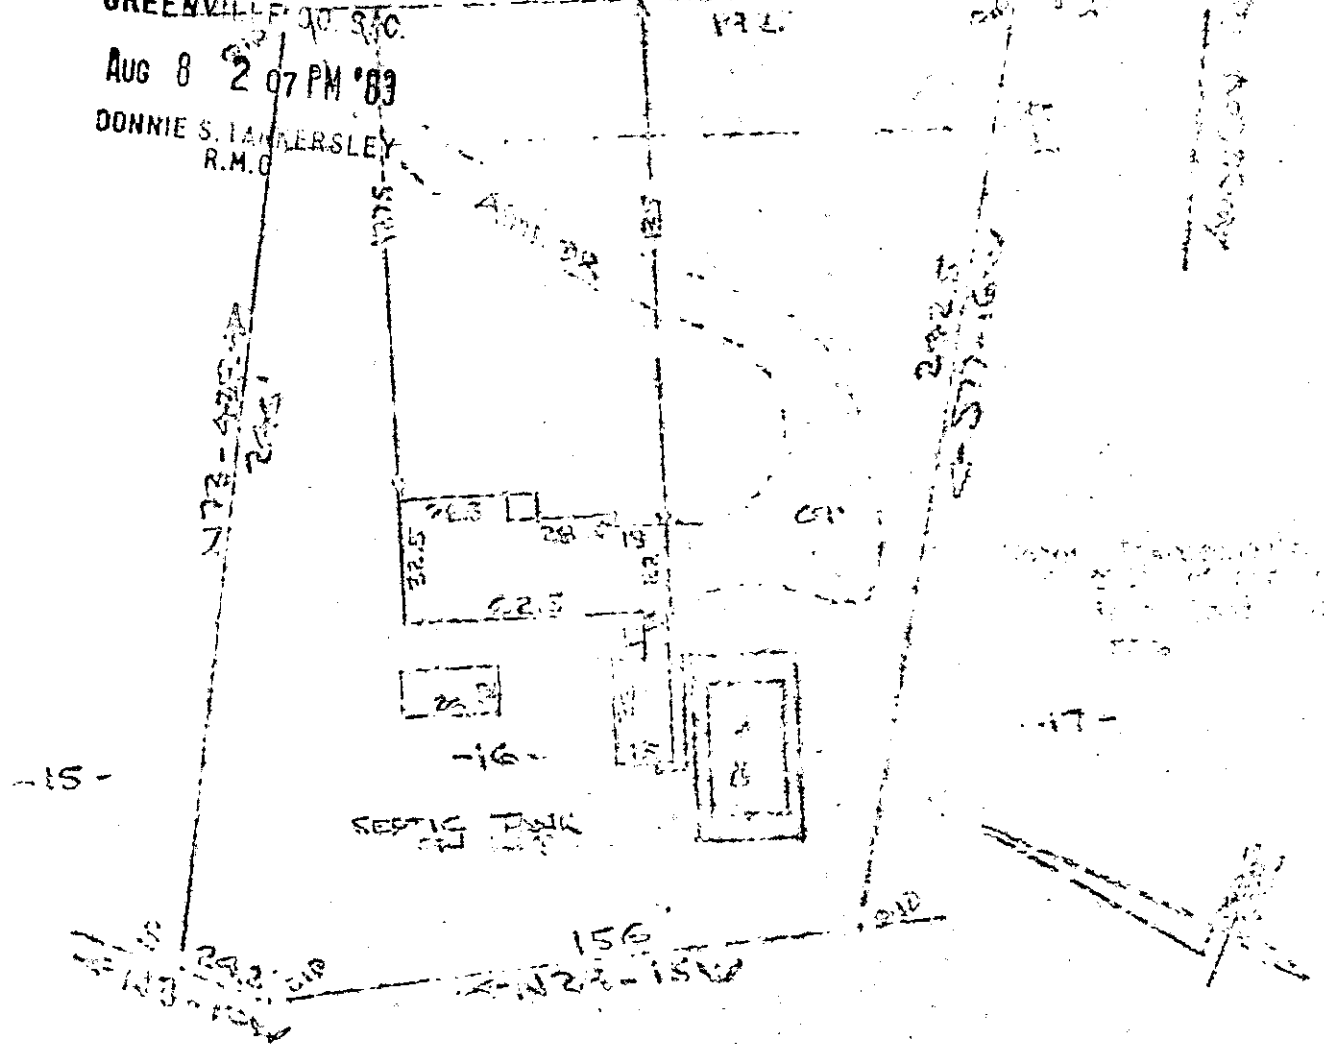

PROPERTY OF  
LINDSEY GAIL WYATT, GRANTOR  
NEAR GREENVILLE, S.C.  
210 156 156

I, the undersigned, being a duly qualified and licensed Land Surveyor in the State of South Carolina, do hereby certify that the foregoing is a true and correct copy of the original survey as shown to me by the grantor, and that the same is in accordance with the original survey as shown to me by the grantor.

✓ 9-Y-46 4597



REGISTERED LAND SURVEYOR, S.C.  
D. PRICE