
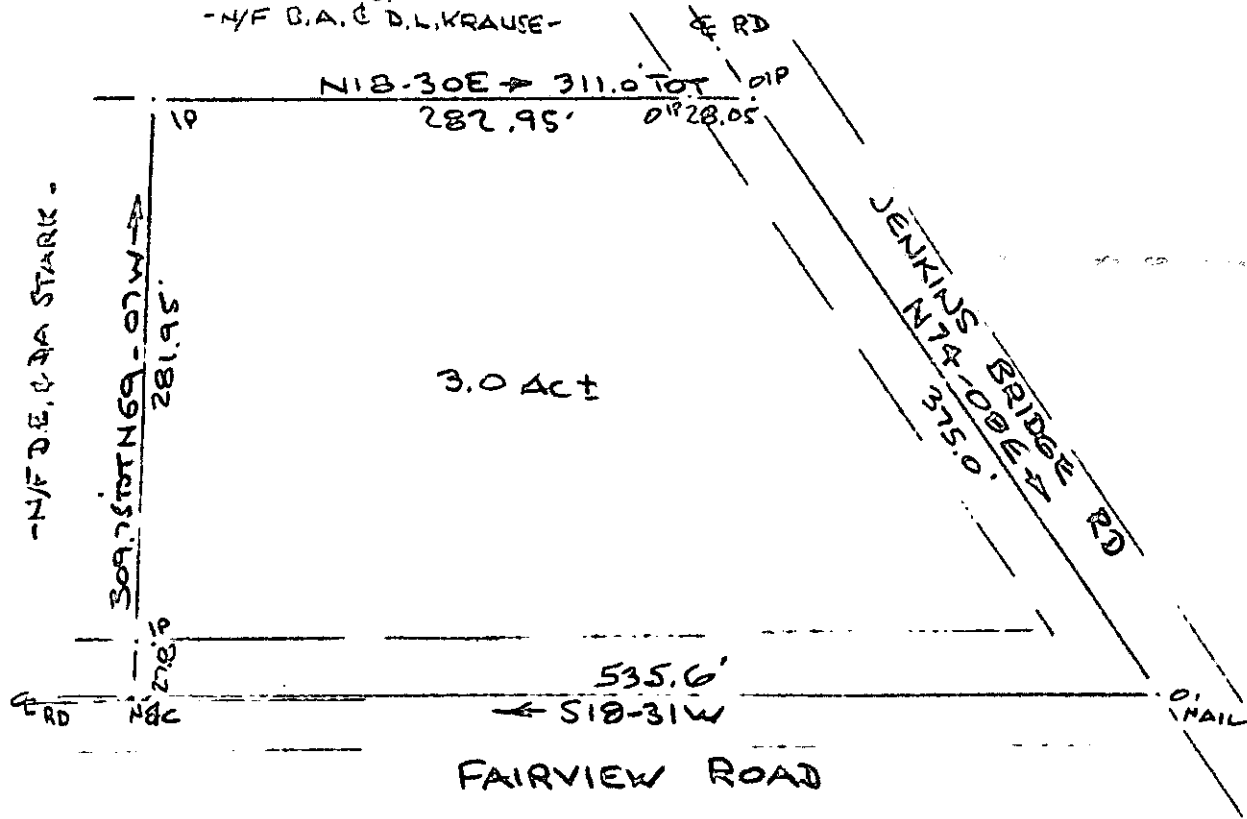


FILED  
GREENVILLE CO. S. C.

AUG 9 2 07 PM '83

DONNIE S. TANKERSLEY  
R.M.C.

- 1/4 B.A. & D.L. KRAUSE -

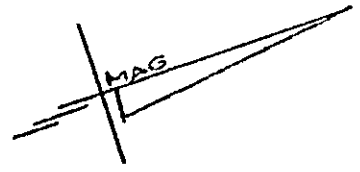


SURVEY FOR  
 ORVILLE A. KRAUSE  
 NEAR GREENVILLE, S.C.  
 100' 19 JULY - 1983 100'

AUG 9 1983

✓ 9 Y - 61

4716

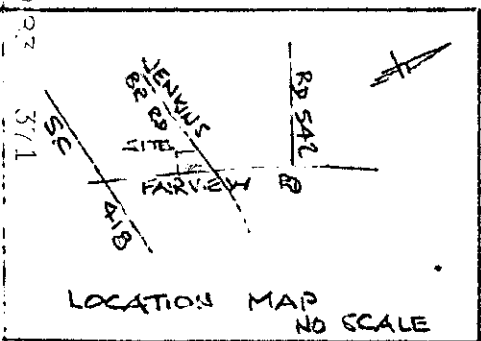

I Certify That The Base of Bearings of the Field Survey  
 is 1/3000 As shown here and that INADP  
 Determined by I.M.C. Method of Greg Galtman

R. P. [Signature]  
 R. L. S. [Signature]  
 CAROLINA SURVEYING CO.  
 AND SURVEYING

CAROLINA SURVEYING CO  
 112 MANLY ST.  
 GREENVILLE, S. C.

2 ALL 9 927

3.0001