


MICROFILMED

FILED  
GREENVILLE CO. S. C.

AUG 15 9 52 AM '83

DONNIE S. TANKERSLEY  
R.M.C.

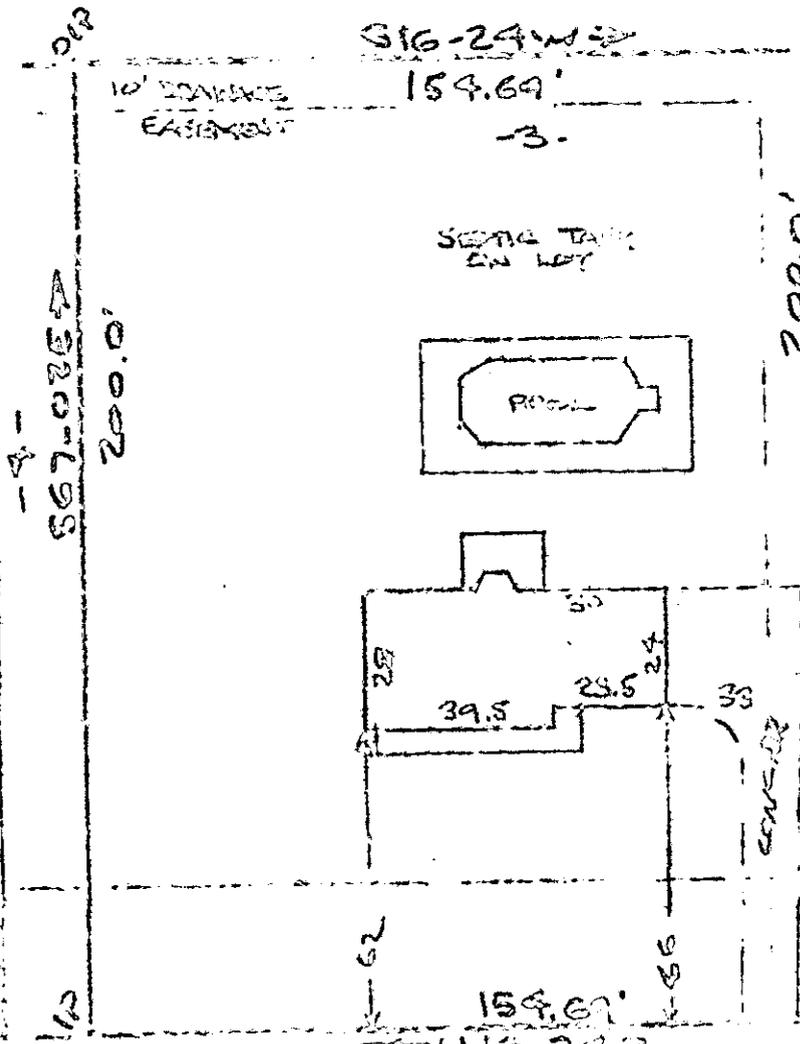

200.0'  
N 87-02 W

-1-

10' EASEMENT EAST

39.5  
23.5  
23.4  
33

39'  
BL

21832'

S.C. HWY 290

COLONY ROAD  
WATER IN ST. R/W


PROPERTY OF  
GEORGE W. TERRELL JR & LINDA TERRELL  
NEAR GREENVILLE, S.C.  
40 LOTS IN 1989 40'

AUG 15 1983

This is to certify that on August 15, 1983, I surveyed the property shown on this plat, being Lots 39, 40 and 41 of COLONY SUBDIVISION, PLAT 11 and recorded in the 1983 Official Greenville County, S.C., in Plat Book "78" at page 114, and that the surveys, walls, wells and buildings are as shown hereon, and that the walls and buildings located on this lot do not encroach on adjacent lots or easements, and that no adjacent walls or buildings encroach on this lot, and so hereby certify that this property is as shown hereon.

5410

94-79

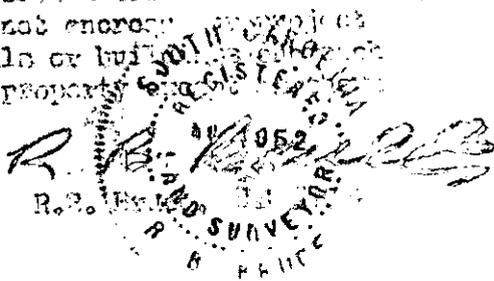

GREENVILLE COUNTY, S.C.  
RECORDED

3 AU 15 83 003

3.0000