

MICROFILMED

FILED  
GREENVILLE CO. S. C.

AUG 16 2 55 PM '83

DONNIE S. TARRERSLEY  
R.M.C.

Note: Improvements on  
this lot are not  
in a flood hazard  
area.

AUG 16 1983

5564

9Y-85


PROPERTY OF  
ELVIRA GUYTON  
NEAR GREENVILLE, S.C.  
50' 15 AUG 12 1983 50'

This is to certify that on the 15th day of August, 1983, I surveyed the property shown on this plat, being known as lot 9 on plat of BLOCK " E " WASHINGTON HEIGHTS and recorded in the RMC Office Greenville County, S. C., in Plat Book " H " at Page 103; and that the property lines, walls and buildings are as shown hereon, and that the walls and buildings located on said lot do not encroach or project on adjacent street or property, and that no adjacent walls or buildings encroach or project on said premises, and no power lines cross this property except as shown hereon. Also being known as PROPERTY OF ELVIRA GUYTON and recorded in Plat Book at Page

CAROLINA SURVEYING CO.  
112 Lady St.  
Greenville, S.C.

3 AU16 83

R. B. [Signature]

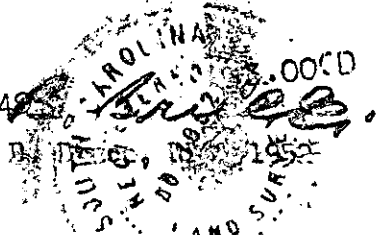

75a/100

170-1-172