


FILED
 GREENVILLE CO. S.C.
 AUG 17 2 49 PM '83
 DONNIE S. JAMES/ERSLEY
 R.M.C.

This is to certify that on June 6, 1983, I surveyed the property shown on this plat, known as Lot 63 on plat of Holly Springs Sec. 2, recorded in the REC Office of Greenville County in Plat Book 4R on page 54, and that the property lines, walls and buildings are as shown hereon; that the building located on said lot does not encroach or project on adjacent streets or property, and that no adjacent walls or buildings encroach or project on said premises, and that no utility lines cross this property except as shown hereon. This property is not located in a designated flood hazard area.

5' drainage and utility easement each side of all side and rear lot lines.

5699

James R. Freeland
 James R. Freeland, RLS & PE #781

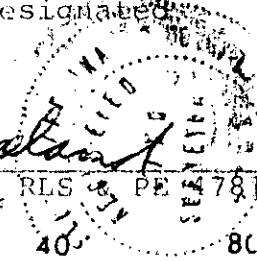


9-Y-89



1783

540.2-1-03

542

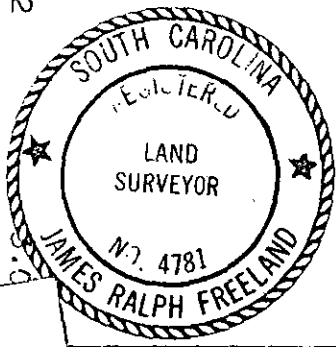

**STATE OF SOUTH CAROLINA
 GREENVILLE COUNTY**

HOLLY SPRINGS
SEC 2 - LOT 63
PROPERTY OF

LUCY ANN C. MILLER

FREELAND & ASSOCIATES
 Engineers • Land Surveyors

GREENVILLE, S.C.

SURVEY JEL & BT
 DRAWN KES
 CHECK JRF
 SCALE 1" = 40'
 DATE 6-6-83
 DWG. NO. 9079

6929

MACHINE INC.