


MICROFILMED

FILED  
GREENVILLE 83-8-8  
AUG 19 4 29 PM '83  
DONNIE S. TANKERSLEY  
R.M.C.

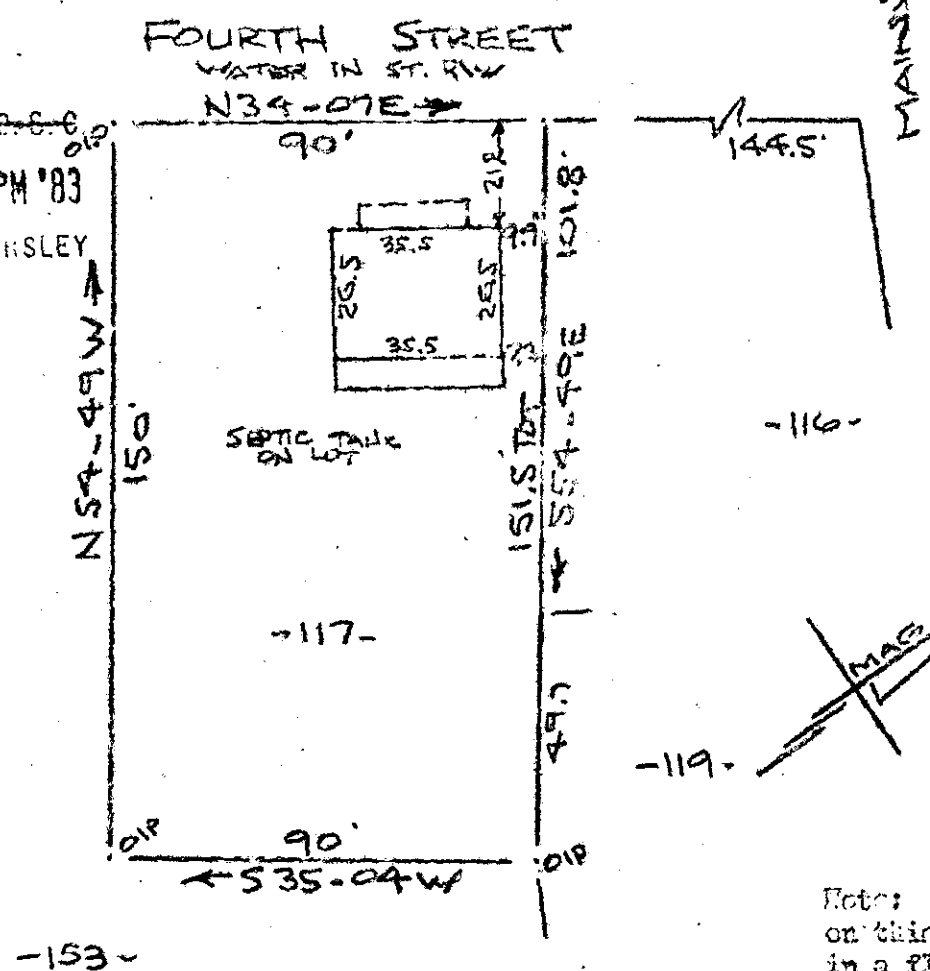

Note: Improvements on this lot are not in a flood hazard area.

G. PROPERTY OF  
MITCHELL GAULT  
NEAR GREENVILLE, S.C.  
40' 15' 10" 40'

AUG 19 1983



SECTION 1 AUG 18 83 683

CAROLINA SURVEYING CO.  
112 Holly St.  
Greenville, N. C.

R. B. Tankersley  
SOUTH CAROLINA  
REGISTERED  
76 1862  
LAND SURVEYOR  
6057  
BRUCE

94-100 ✓

3.0001