


Note:  
Improvements on this  
lot are not in a  
flood hazard area.

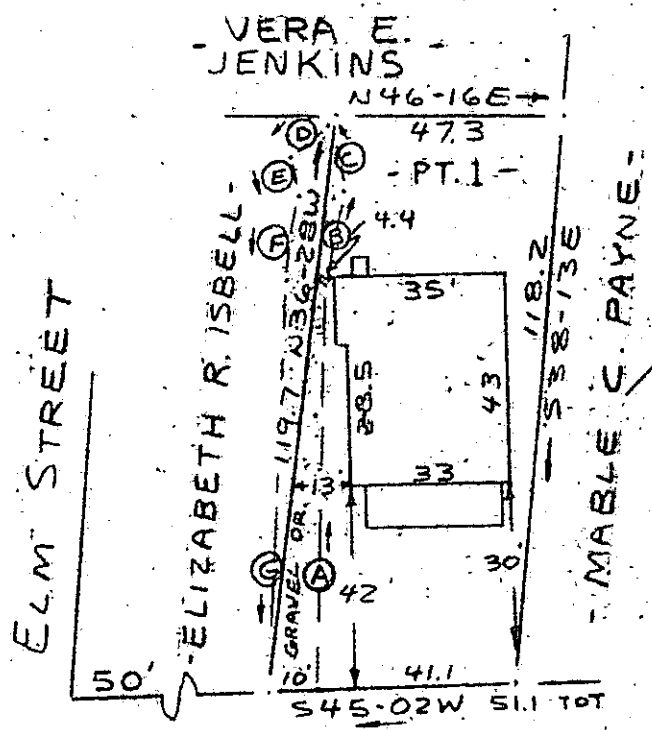

A	887	N42-12W
B	19.8	N32-05W
C	14.2	N56-12W
D	10.0	S7-34W
E	8.3	S54-19E
F	17.4	S34-77E
G	856	S41-00E

FILED  
GREENVILLE CO. S.C.  
AUG 29 2 42 PM '83  
DONNIE S. TARKERSLEY  
R.M.C.


MILLS AVENUE  
WATER & SEWER IN ST. R/W

9-2-21

6951

PROPERTY OF  
PEACE-HAGOOD ASSOCIATES  
GREENVILLE CO., GREENVILLE, S.C.

SCALE: 1"=40' 24 MARCH 1983 AUG 29 1983

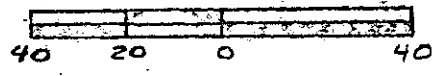

This is to certify that on the 24th day of March, 1983, I surveyed the property shown on this plat, being known as part of lot 1 on plat of PROPERTY OF PEACE-HAGOOD ASSOCIATES and recorded in the RMC Office Greenville County, S. C., in Plat Book " " at Page ; and that the property lines, walls and buildings are as shown hereon, and that the walls and buildings located on said lot do not encroach or project on adjacent street or property, and that no adjacent walls or buildings encroach or project on said premises, and no power lines cross this property except as shown hereon.

*R. B. Bruce*  
R. B. Bruce, RLS #1952

CAROLINA SURVEYING CO. 021  
112 Manly St.  
Greenville, S.C.

