


\$ 425.00
\$ 100.00
\$ 525.00

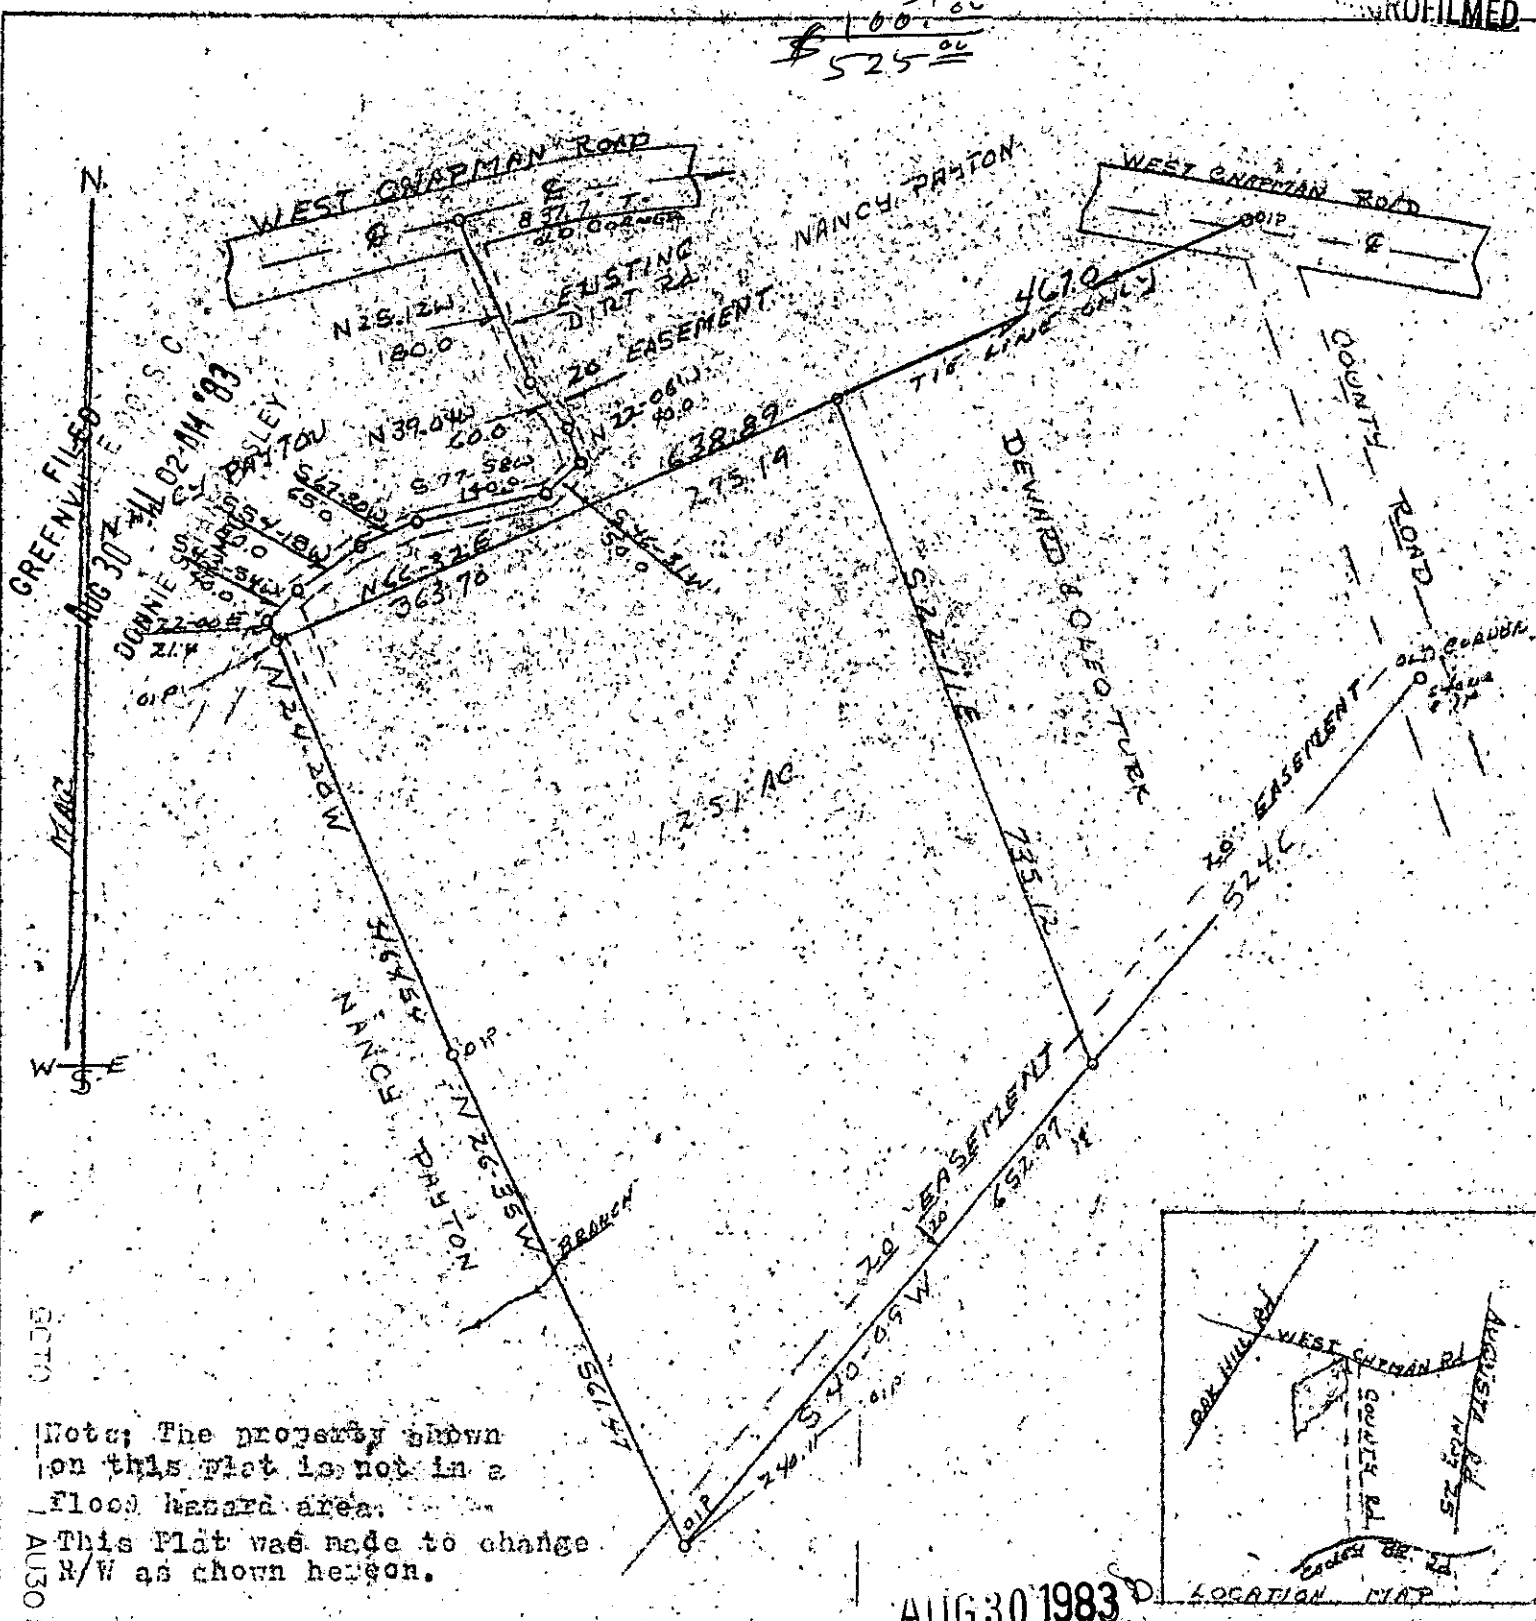

Notes: The property shown on this plat is not in a flood hazard area.
 This Plat was made to change R/W as shown hereon.

AUG 30 1983

7118 ✓

PROPERTY OF
 RICHARD & NANCY JONES

97-26

State of South Carolina
 Greenville County

The above property is located approximately four miles south East of Ware Place.

This Property may be subject to Easements or R/Ws other than shown on Plat.


Party Chief
 Frank Duncan

REGISTERED
 T. FRANK DUNCAN
 10.17.82

Reg No 1412 L.S.

7/11/85

Scale: 1" = 200'

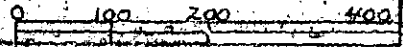

SECTION 1539 AUG 30 83