
50

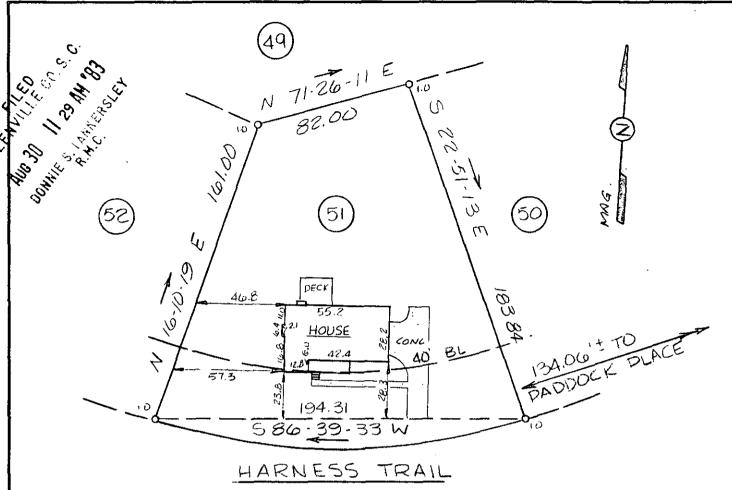

This is to certify that on August 17, 1983, I surveyed the property shown on this plat, known as Lot 51 on the plat of Heritage Lakes, recorded in the RMC Office of Greenville County in Plat Book 6H on page 16 and that the property lines, walls and buildings are as shown hereon; that the building located on said lot does not encreach or project on adjacent streets or property, and that no adjacent walls or buildings encroach or project on said premises, and that no utility lines cross this property except as shown hereon. This property is not located in a designated flood hazard area.

Note: Except where shown otherwise, <u>ALL</u> lots to have 10' utility and drainage easement along side and rear lines.

AUG 30 1983 to Land RLS 4781



## STATE OF SOUTH CAROLINA GREENVILLE COUNTY

HERITAGE LAKES SUBDIVISION

LOT 51

100

feet

PROPERTY OF

ROGER L. QUENOUILLERE
MARIE LOUISE QUENOUILLERE

FREELAND & ASSOCIATES

Engineers • Land Surveyors

7121

24.2....

GREENVILLE, S.C.

SURVEY DG

DRAWN KEG

CHECK //// C

SCALE 1"-50

DATE 8-17-83

DWG, NO. 9584

PRINT MACHINE INC.

8736