MICROFILMED

FILED
GREENVILLE CO. S. C.
AUG 30 3 42 PM '83
DONNIE S. TANKERSLEY
R.M.C.

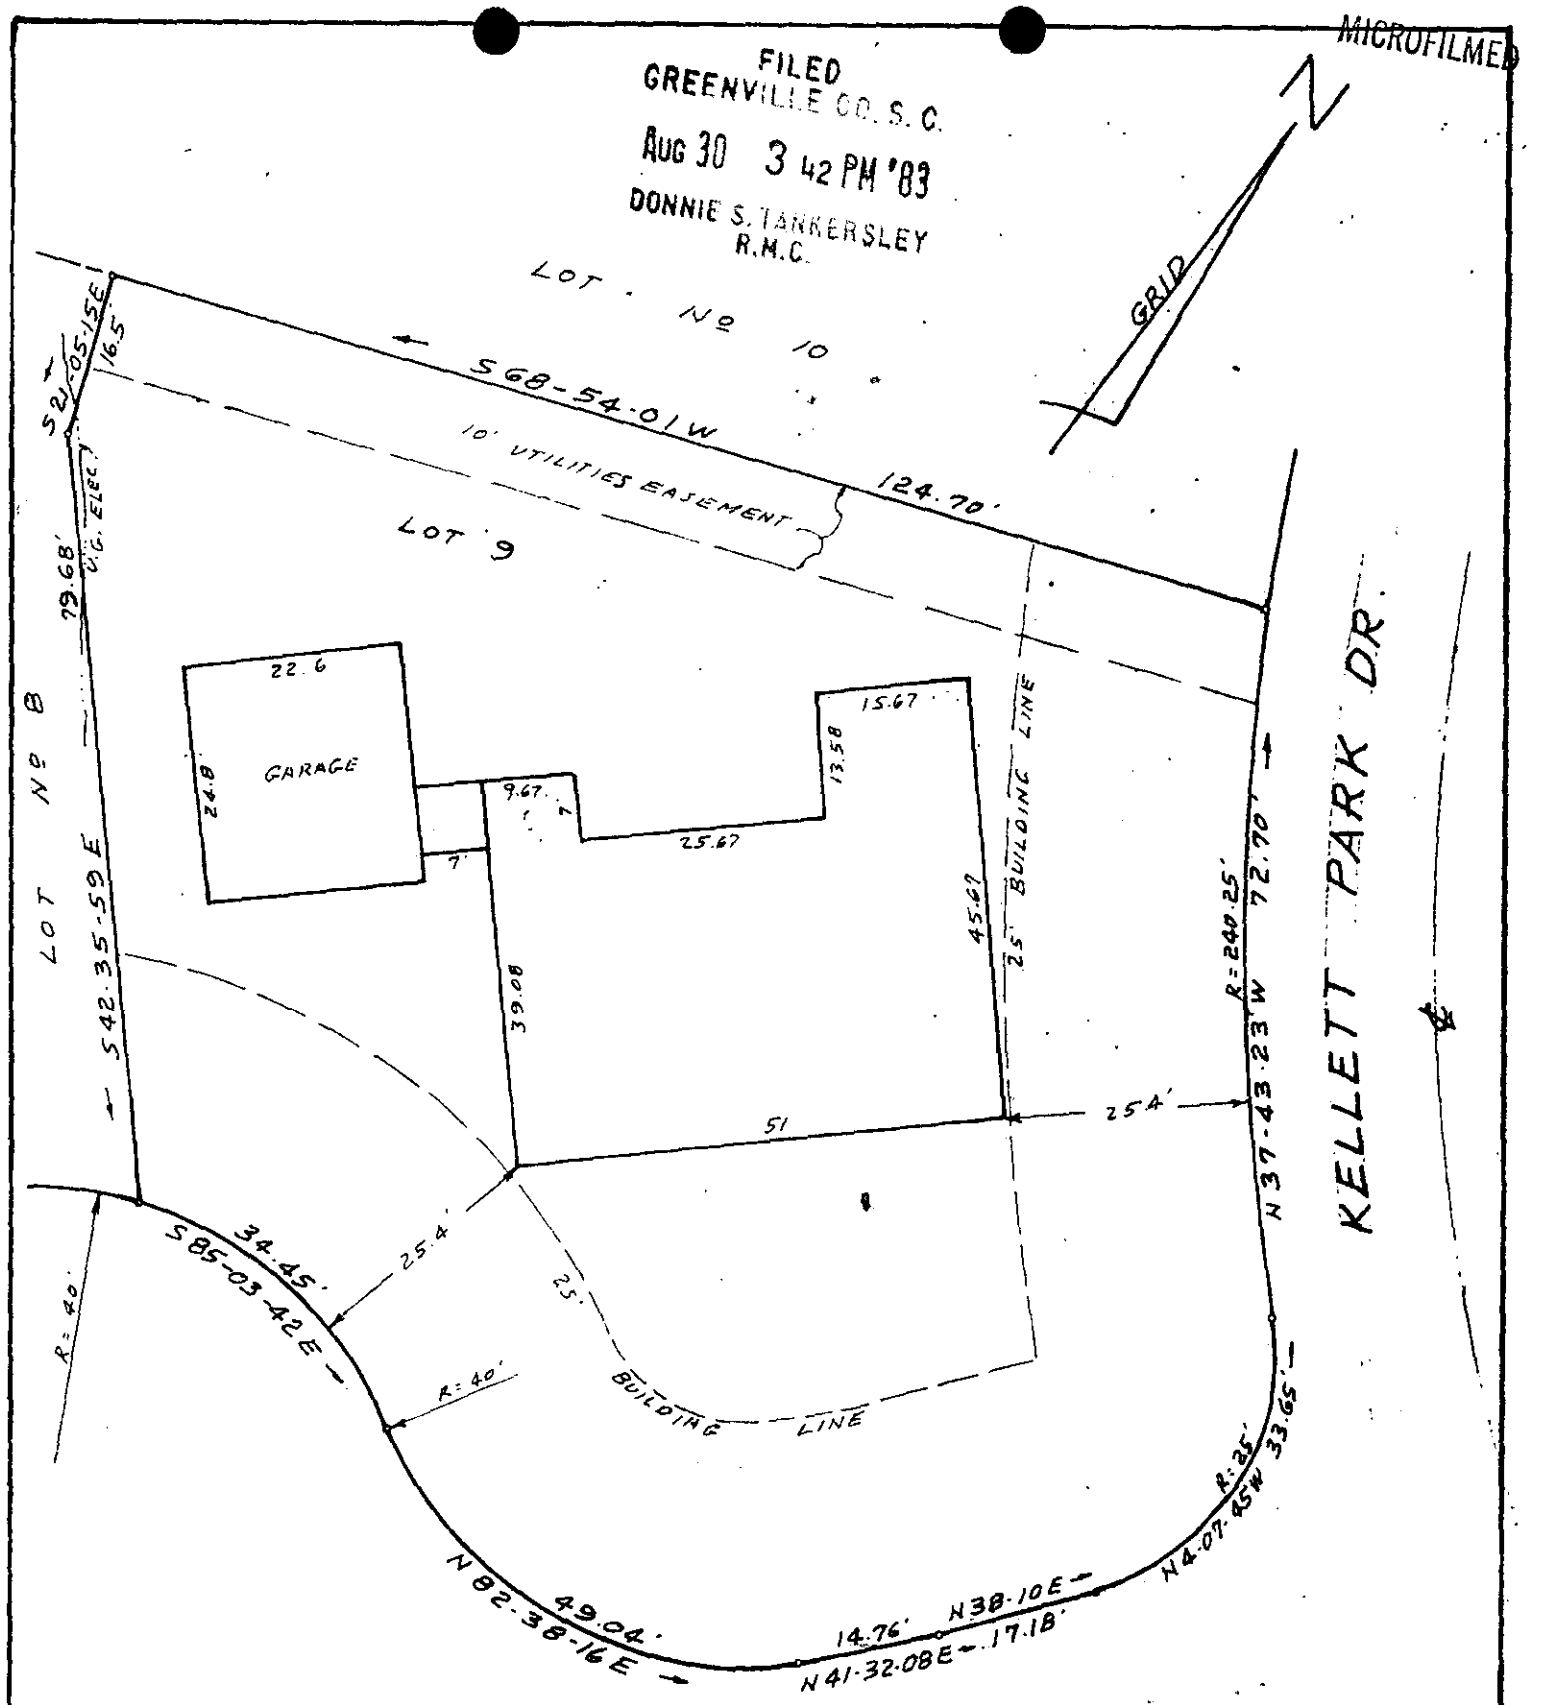

FOUNDATION SURVEY FOR
KELLETT PARK, INC.
GREENVILLE, S.C.
SCALE 1" = 20' AUG. 2, 1983

REF: LOT No 9 ON PLAT OF KELLETT PARK, SECTION ONE, RECORDED IN PLAT BOOK 9F, PAGE 89

NOTE: DRAINAGE EASEMENT 5' EACH SIDE OF SIDE AND REAR LOT LINES. DRAINAGE AND UTILITIES EASEMENT 5' OUTSIDE STREET R/W.

I certify yhat this is an accurate plat of a survey made by me August 2nd., 1983, that the structure located on said premises does not encroach or project on adjacent streets or property, and that the lot is not located in a designated 100 year flood plain.

7197

9-I-32

AUG 30 1983

SOUTH CAROLINA REGISTERED LAND SURVEYOR No. 1347 CLARK JOHN WILBAR

C. O. Reddle
RLS #1347, Greenville, S.C.

5.00 CD