MICROFILMED

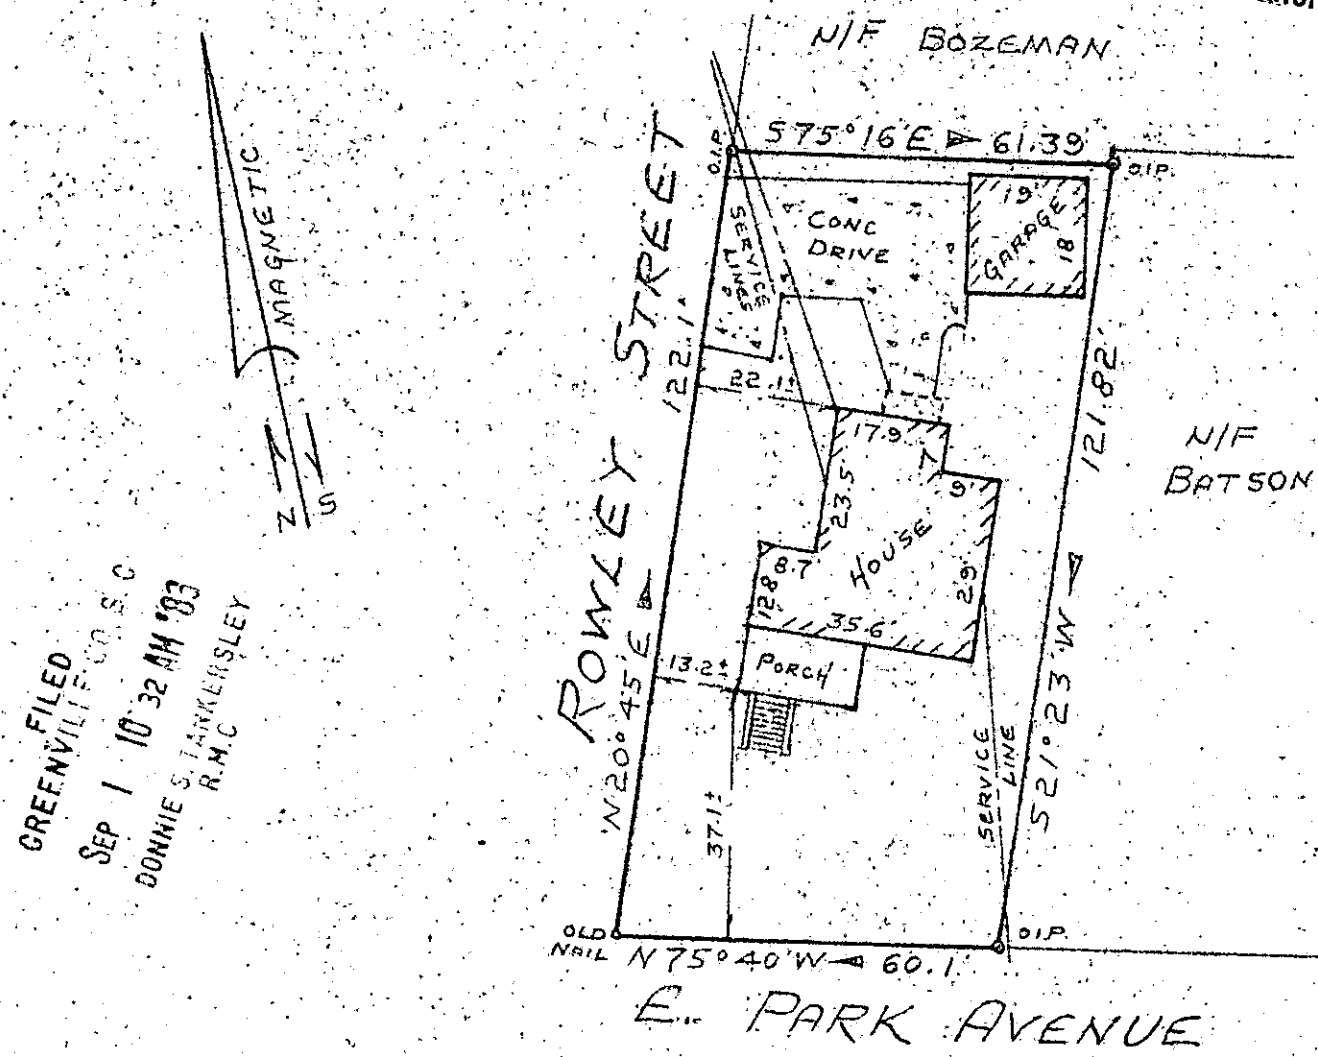

FILED
GREENVILLE CO. S.C.
SEP 1 10 32 AM '83
DONNIE S. TANKERSLEY
R.M.C.

PROPERTY OF
VIRGIL THOMAS
GREENVILLE, GREENVILLE COUNTY, S.C.
AUG 5, 1983 SCALE 1" = 30'

SEP 1 1983

9-2-40 7486

This is to certify that on August 5, 1983, I surveyed the property shown on this plat, known as Lucille Edna H. Bissinnar Property, as recorded in Deed Book 616, Page 225, in the RMC Office for Greenville County, and that the property lines, walls and buildings are as shown hereon, and that the building located on said lot does not project nor encroach on adjacent streets or property, and that no adjacent walls or buildings project nor encroach on said lot, and that no utility lines cross this lot except as may be shown hereon. The degree of accruacy is 1/8,000.

NOTE: This property is not located within a flood hazard area.

Survey by: Richard DU Wooten, Jr.
Greenville, South Carolina

S. C. R. E. S. No. 4678

SEP 1 '83 111
3.00CI