

GREENVILLE CO. S.C.  
FILED  
SEP 15 10 06 AM '83  
PONTIE S. TANKERSLEY  
R.M.C.

LOT 319    LOT 320    LOT 321    LOT 322

M.H.    25' S.S. Easement    Sanitary Sewer

N 75-09W    N 86-48W 91.07'    N 76-27W    S 67-18W 55.35'

+ 868.3    Creek is Line    30' Drainage Easement

869-100 YR.

LOT 311  
SEC. NO. 14

FLOOD CONTOUR


79.88'    144.88'    Total

LARRY & SUSAN LINEBERGER



LOT 312

S 4-53 E 187.65'    25' S.S.E.

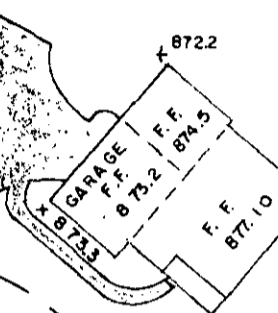

PART LOT 310

PART LOT 310

WINDWARD COURT

+ 877.9

WINDWARD WAY

SEP 15 1983

PROPERTY OF

LOREN N. BURCH

9-Z-74


NANCI P. BURCH

GREENVILLE CO., S.C.

8884

Scale 1" = 50'    August, 1983

This is to certify that on the 19th day of August, 1983, we surveyed the property shown on this plat being known as Lot 311 & Part Lot 310 on plat of Davenger Place, Section No. 14, recorded in plat book 9-F, page 30, Office of R.M.C., Greenville County, S.C.; and that the property lines, walls and buildings are as shown hereon; that the buildings located on said lot do not encroach or project on adjacent streets or property; and that no adjacent buildings or walls encroach or project on said premises.

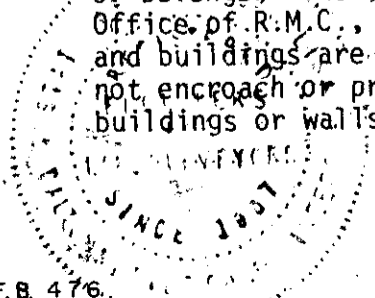

*R.W. Dalton*  
DALTON & NEVES CO., ENGINEERS