

FILED
 SEP 16 2 31 PM '83
 GREENVILLE CO S.C.
 DONNIE S. JANTRESELEY
 R.M.C.


This is to certify that on September 9, 1983, I surveyed the property shown on this plat, known as part of Lot 117 on the plat of Dovetree recorded in the PMC Office of Greenville County in Plat Book 4R on pages 8 thru 13 and that the property lines, walls and buildings are as shown hereon; that the building located on said lot does not encroach or project on adjacent streets or property and that no adjacent walls or buildings encroach or project on said premises, and that no utility lines cross this property except as shown hereon. This property is not located in a designated flood hazard area.

James R. Freeland
 James R. Freeland RLS & PE 4781
 SCALE 40 0 40 80 FEET

NOTE:
 5' drainage & utility easement each side of all side & rear lot lines.
 9-2-79 ✓ 9085

**STATE OF SOUTH CAROLINA
 GREENVILLE COUNTY**

FREELAND & ASSOCIATES
 Engineers • Land Surveyors
 GREENVILLE, S.C.

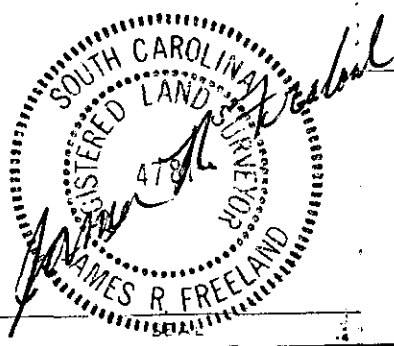

DOVE TREE
PART LOT 117
PROPERTY OF
WILLIAM A. MOORE
NORMA W. MOORE

SURVEY H.B.
 DRAWN K.E.G.
 CHECK M.C.
 SCALE 1" = 40'
 DATE 9-9-83
 DWG. NO. 9693

300 3 3:42 PM 011