



This is to certify that on September 9, 1983, I surveyed the property shown on this plat, known as Lot 42 on the plat of Pelham Estates, Sec.3, recorded in the RMC Office of Greenville County in Plat Book 5A on page 71 and that the property lines, walls and buildings are as shown hereon; that the building located on said lot does not encroach or project on adjacent streets or property and that no adjacent walls or buildings encroach or project on said premises, and that no utility lines cross this property except as shown hereon. This property is not located in a designated flood hazard area.

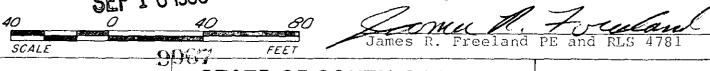

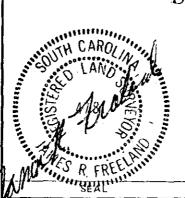

00

PRINT MACHINE, INCO BEING 9 C

STATE OF SOUTH CAROLINA GREENVILLE COUNTY

PELHAM ESTATES

SEC. 3; LOT 42

PROPERTY OF

WALTER H. BURGESS

MARY M. BURGESS

FREELAND & ASSOCIATES

Engineers • Land Surveyors

GREENVILLE, S.C.

SURVEY H.B.	
DRAWN K.E.G.	
CHECK M.C.	
SCALE /"=40'	
DATE 9-9-83	
DWG. NO. 969/	