MICROFILMED

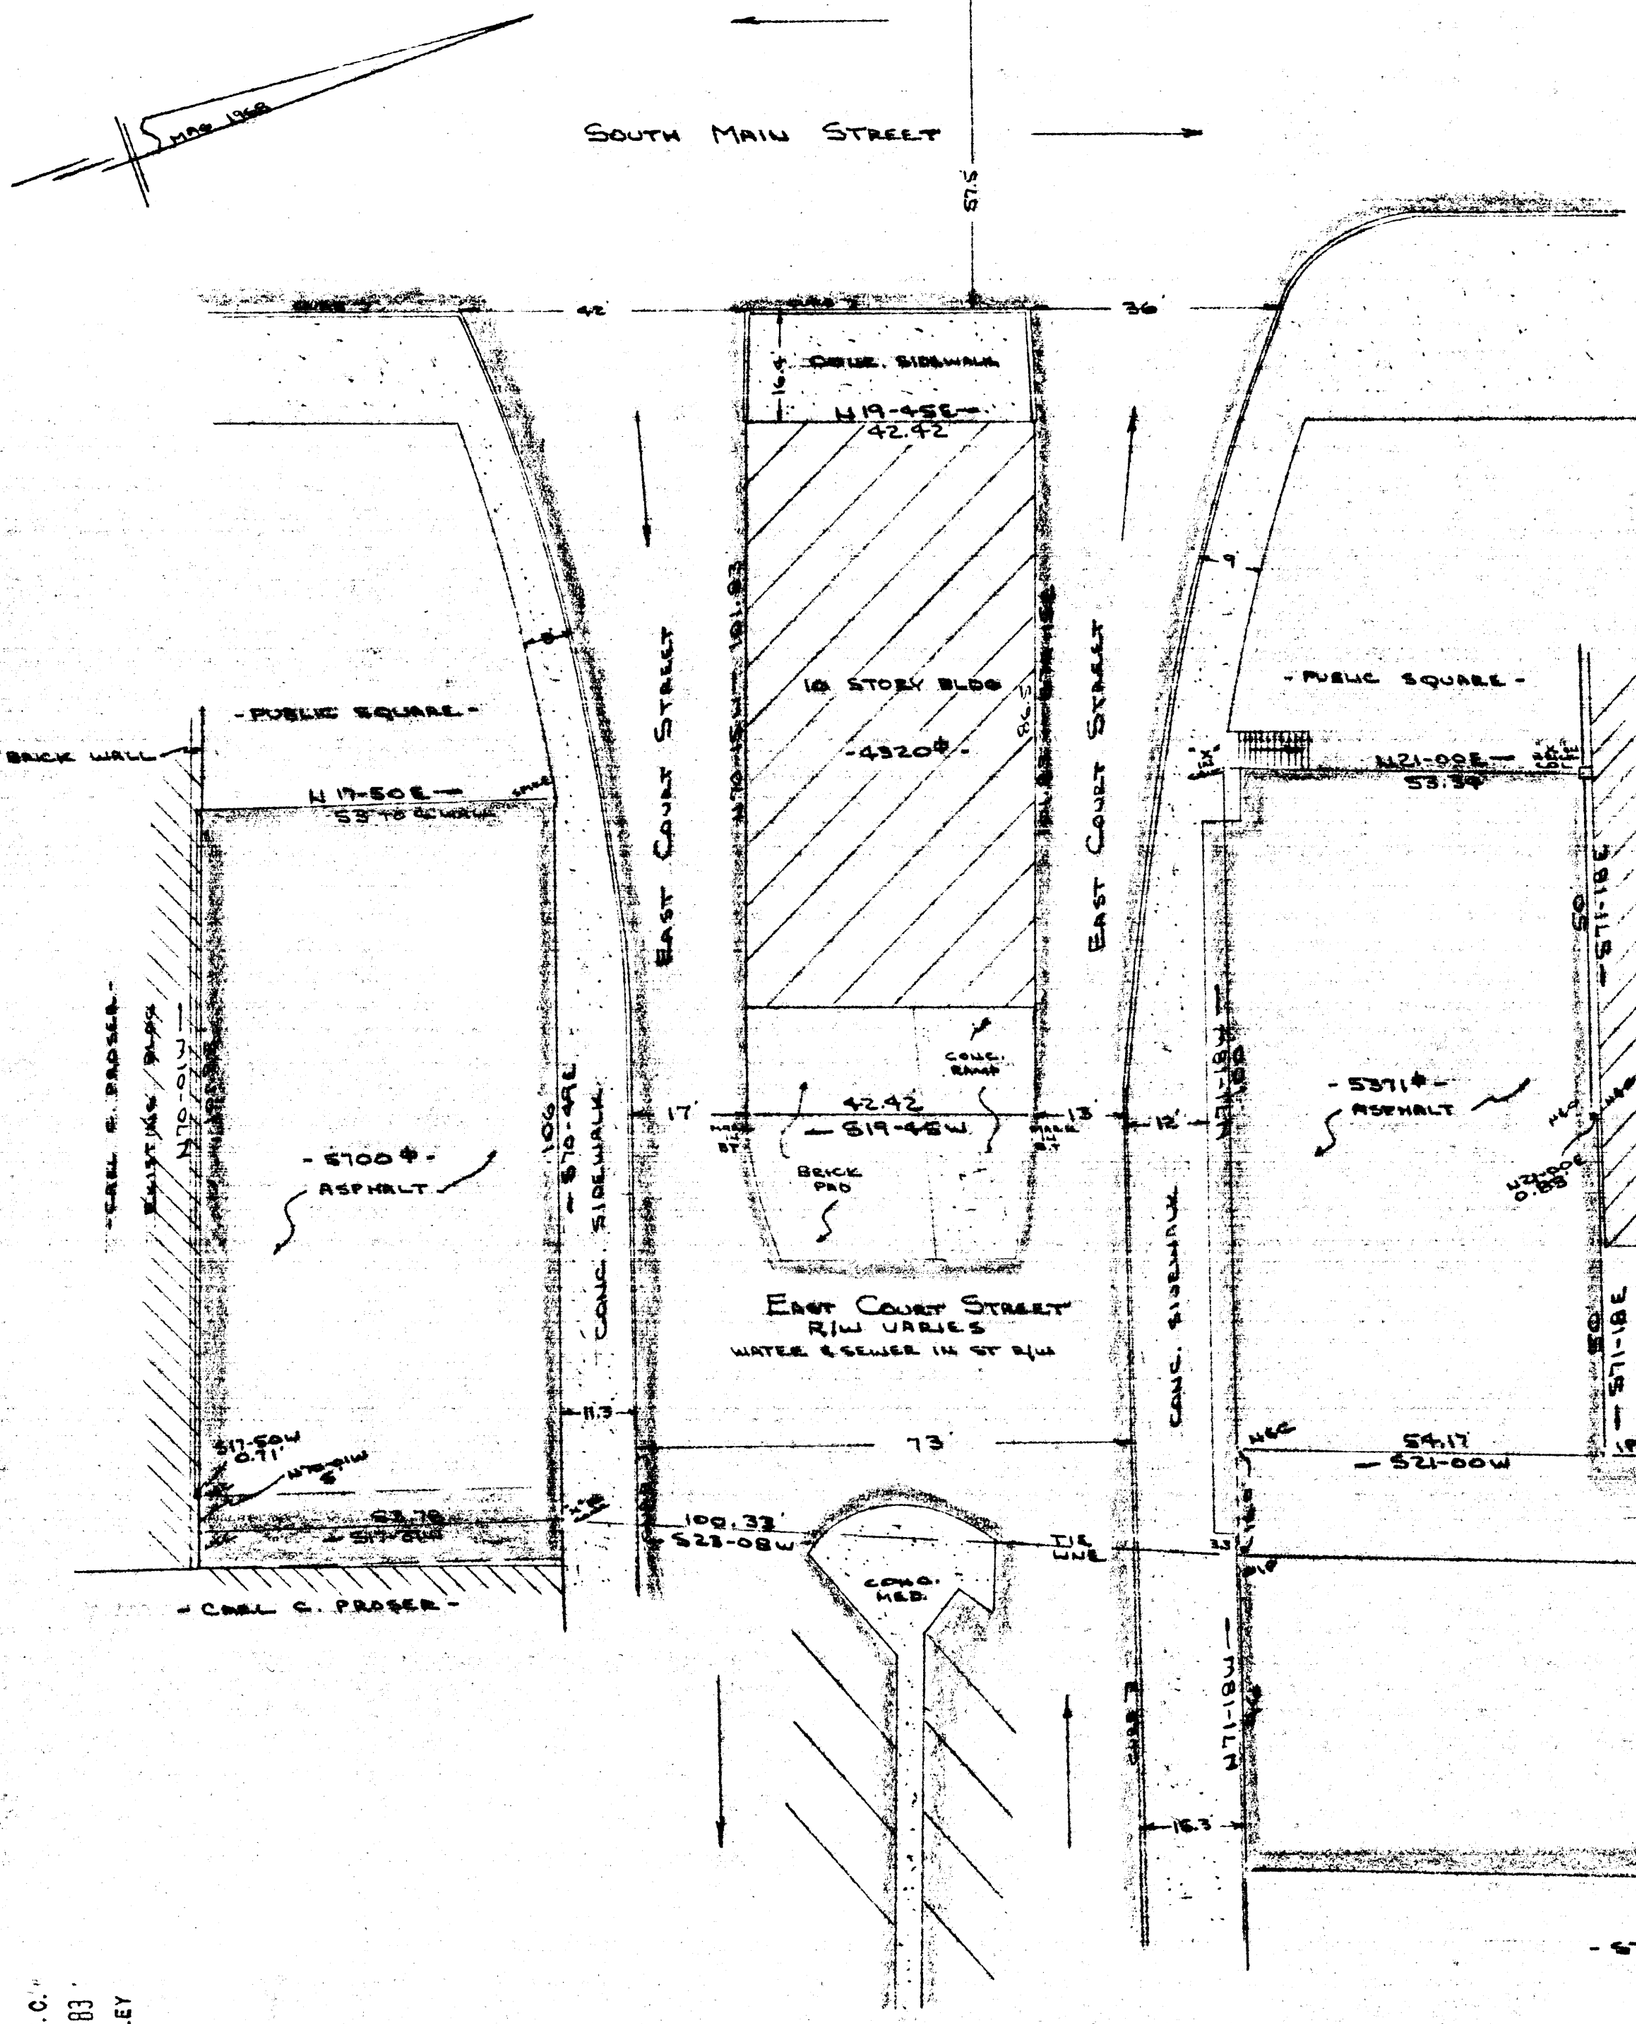

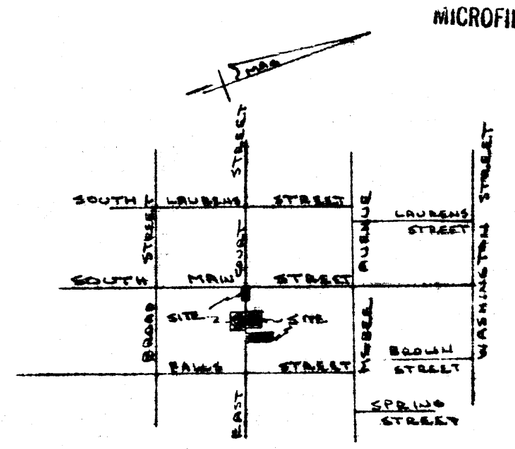

LOCATION MAP
NO SCALE

REFERENCES:
BLOCK BOOK - 59-7-1
" - 59-5-7
" - 59-1-17
" - 59-1-18
DEEDS - BK 1194 @ P. 291
" - " 1058 @ P. 271
" - " 1131 @ P. 503
" - " 1160 @ P. 322
PLATS - BK 9Y @ P. 73
" - " E @ P. 187
" - " FF @ P. 516

FILED
GREENVILLE CO. S. C.
NOV 3 3 34 PM '83
DONNIE S. TANKERSLEY
R.M.C.

SURVEY FOR
ONE THIRTY FIVE SOUTH MAIN STREET ASSOCIATES, LTD.
GREENVILLE COUNTY, GREENVILLE, S.C.
20 OCT 1983

20 10 0 20 40

I Certify That The Ratio Of Precision Of The Field Survey Is 1/10,000 As Shown Hereon And That The Area Determined By D.M.D. Method Of Area Calculations.

R. B. Bruce
RLS No. 1952
SOUTH CAROLINA
R. B. BRUCE
LAND SURVEYOR

14763 ✓
NOV 3 1983
10-A-33

CAROLINA SURVEYING CO.
112 MANLY ST.
GREENVILLE, S.C.

265/15

5.08(1/83 BC) 11A07