


I hereby certify that the ratio of precision of the field survey is 1:5000 as shown hereon and the area was determined by DMD Method.

*W.B. Huntley III*  
W.B. Huntley III RLS 8809

19.85 AC. TOTAL  
- 0.89 AC. RD. R/W  
18.96 AC. NET.

FILED  
GREENVILLE CO. S.C.  
FEB 28 2 32 PM '84  
DORRIS S. HENSLEY  
R.M.C.

FEB 28 1984  
26450  
10-A-99

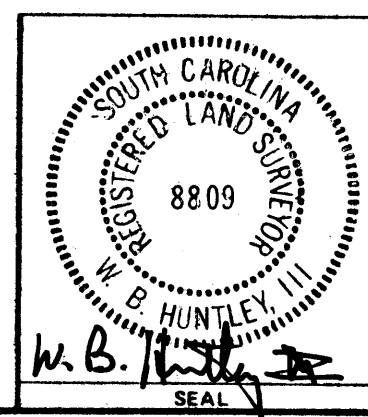

<b>STATE OF SOUTH CAROLINA</b>		FREELAND & ASSOCIATES Engineers • Land Surveyors GREENVILLE, S.C.				
<b>GREENVILLE COUNTY</b>						
<b>SURVEY FOR</b>						
<b>SUNBELT PROPERTIES</b>						
<b>INC.</b>						
SURVEY	WBH III	<table border="1"> <tr><td>DATE</td><td>FEB 27 84</td></tr> <tr><td>DWG. NO.</td><td>10, 539</td></tr> </table>	DATE	FEB 27 84	DWG. NO.	10, 539
DATE	FEB 27 84					
DWG. NO.	10, 539					
DRAWN	B.R.					
CHECK	M.C.					
SCALE	1" = 100'					
DATE	FEB 27 84					