


MICROFILMED

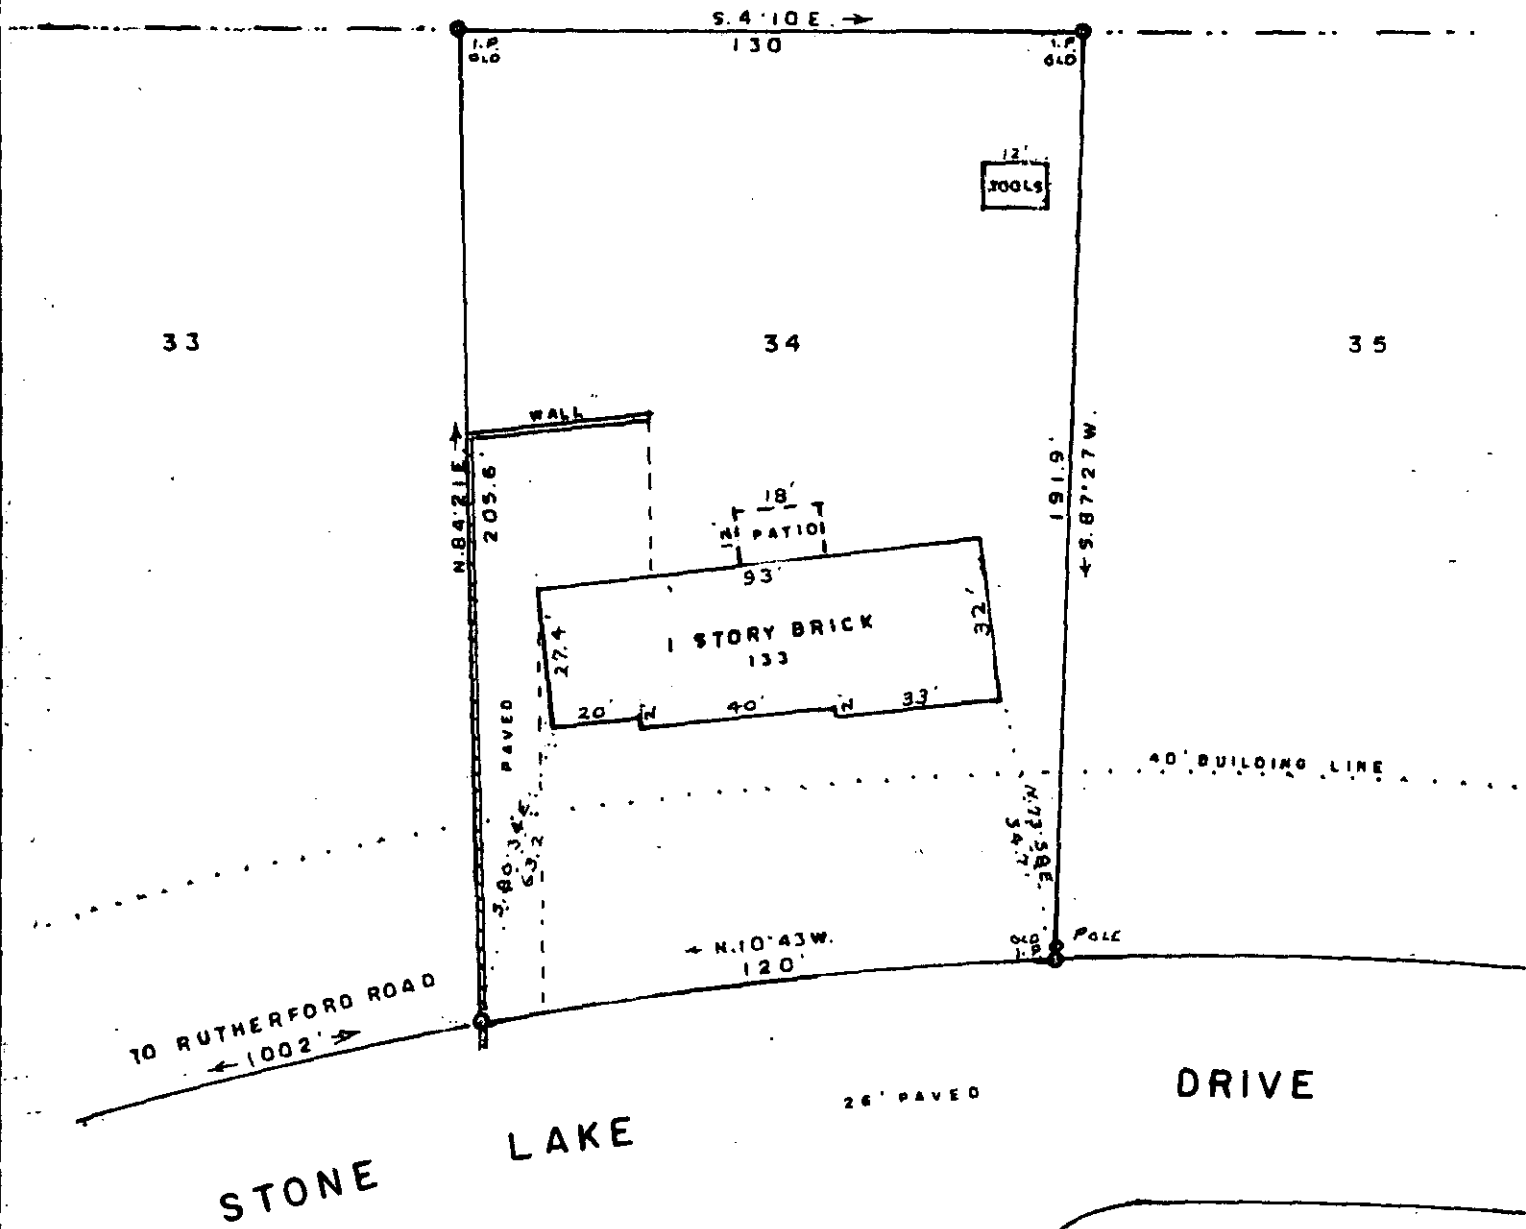

PROPERTY OF
VIRGINIA H. GIBSON
 STONE LAKE HEIGHTS
 CITY OF GREENVILLE, S.C.

SCALE 1" = 40' SEPT. 16, 1983

GOOCH & ASSOCIATES
 SURVEYORS

SEP 29 1983

FILED
 SEP 29 1983
 Bonnie S. Tankersley

10-B-24 10573 ✓

BEING LOT NO. 34, SECTION 3, OF STONE LAKE HEIGHTS. SEE PLATBOOK 00, PAGE 96.

I HEREBY CERTIFY THAT THE MEASUREMENTS SHOWN HEREON ARE CORRECT AND THERE ARE NO ENCROACHMENTS OR PROJECTIONS UNLESS OTHERWISE SHOWN.

THIS IS TO CERTIFY THAT I HAVE CONSULTED THE FEDERAL INSURANCE ADMINISTRATION FLOOD HAZARD BOUNDARY MAPS, AND FOUND THAT THE ABOVE DESCRIBED PROPERTY IS NOT LOCATED IN A SPECIAL FLOOD HAZARD AREA.

SIGNED *John S. Gooch*