


MICROFILMED

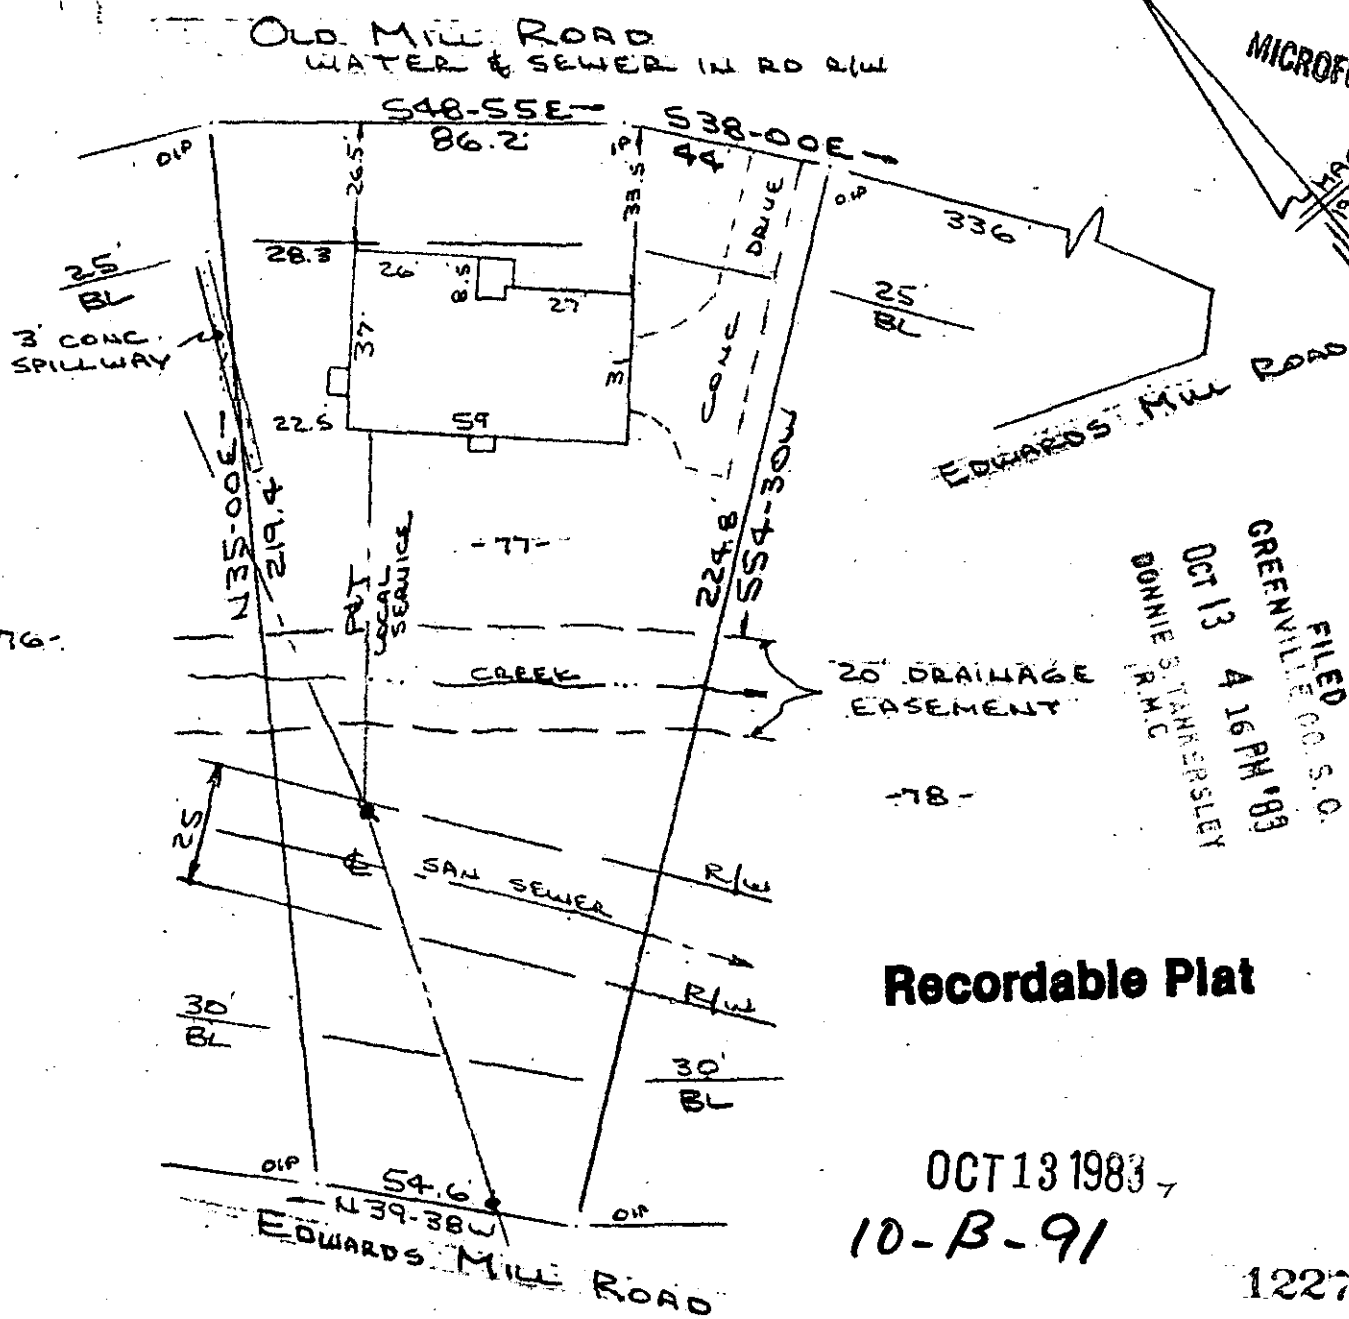


FILED  
 GREENVILLE CO. S. C.  
 OCT 13 4 16 PM '83  
 BONNIE STANBERSLEY  
 R.M.C.

### Recordable Plat

OCT 13 1983  
 10-B-91

12273

PROPERTY OF  
**DAVID H. ROBERTS**  
 NEAR GREENVILLE, GREENVILLE COUNTY, S.C.  
 12 OCT. 1983

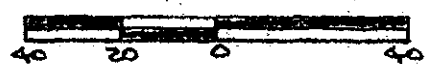

This is to certify that on the 12th day of October, 1983, I surveyed the property shown on this plat, being known as lot 77 on plat of EDWARDS FOREST HEIGHTS and recorded in the RMC Office Greenville County, S. C., in Plat Book "000" at Page 89; and that the property lines, walls and buildings are as shown hereon, and that the walls and buildings located on said lot do not encroach or project on adjacent street or property, and that no adjacent walls or buildings encroach or project on said premises, and no power lines cross this property except as shown hereon. Also known as PROPERTY OF DAVID H. ROBERTS and recorded in Plat Book \_\_\_\_\_ at Page \_\_\_\_\_

CAROLINA SURVEYING CO.  
 112 Manly St.  
 Greenville, S. C.  
 R. B. Bruce, FLS #1952

*R. B. Bruce*

100 8 11801