MICROFILMED

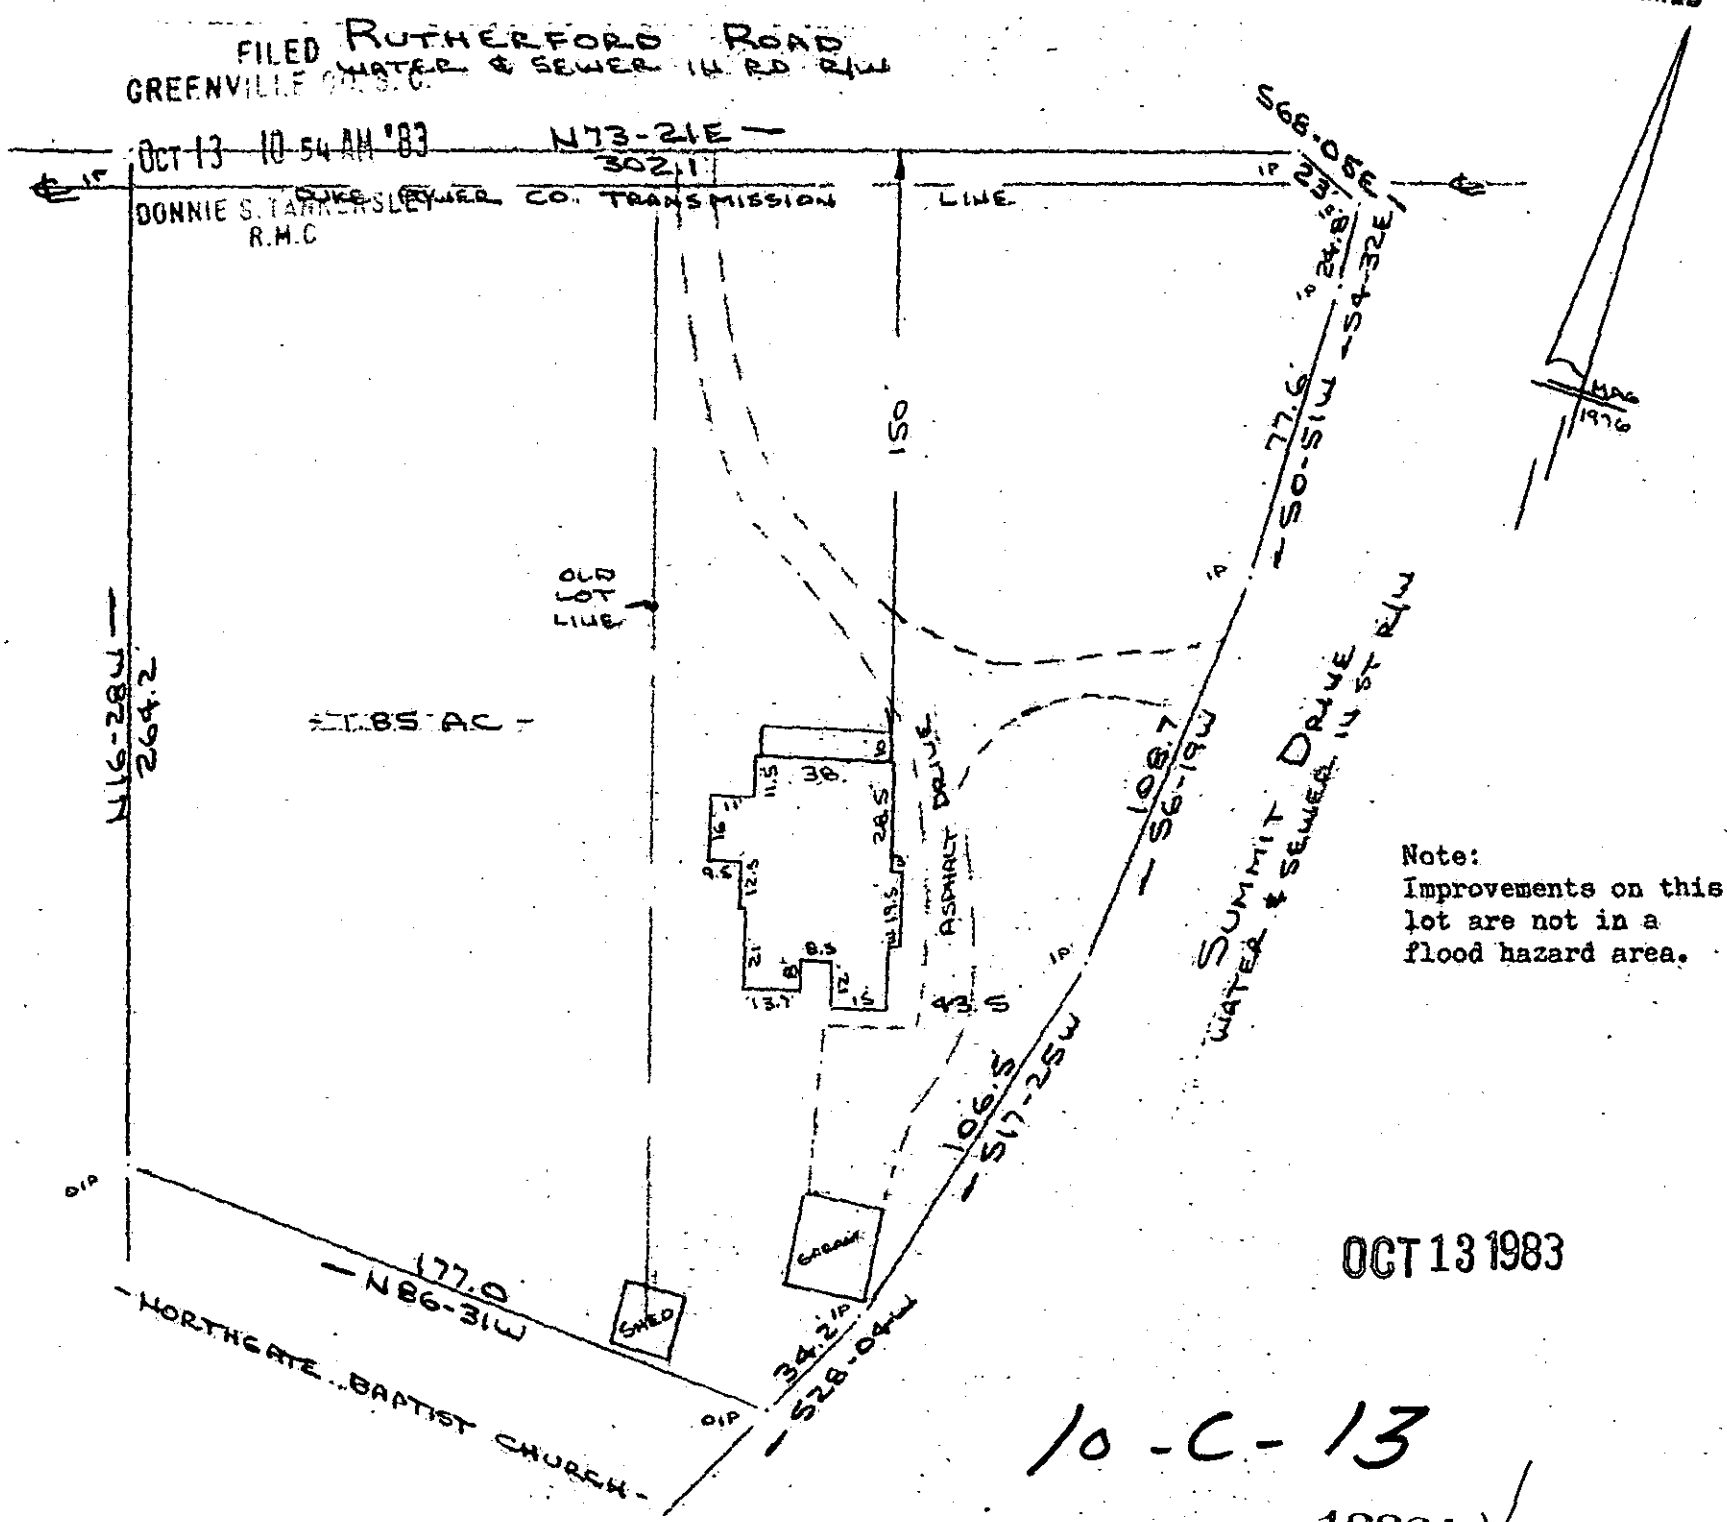

Note:
Improvements on this lot are not in a flood hazard area.

OCT 13 1983

10-C-13

12264 ✓

PROPERTY OF
RAYMOND H. LOPER
GREENVILLE COUNTY, GREENVILLE, S.C.
3 OCT 1983

50 25 0 50

This is to certify that on the 3rd day of October, 1983, I surveyed the property shown on this plat, being known as 1.85 acres on plat of PROPERTY OF RAYMOND H. LOPER and recorded in the RMC Office Greenville County, S. C., in Plat Book at Page ; and that the property lines, walls and buildings are as shown hereon, and that the walls and buildings located on said lot do not encroach or project on adjacent street or property, and that no adjacent walls or buildings encroach or project on said premises, and no power lines cross this property except as shown hereon.

CAROLINA SURVEYING CO.
112 Manly St.
Greenville, S. C.

R. B. Bruce
R. B. Bruce, RLS #1958

257/42-44 182-2-52.3 & 53.1 2 OCT 1983 020 5.00CI