


POTOMAC AVENUE

WATER & SEWER IN STR/W

MICROFILMED

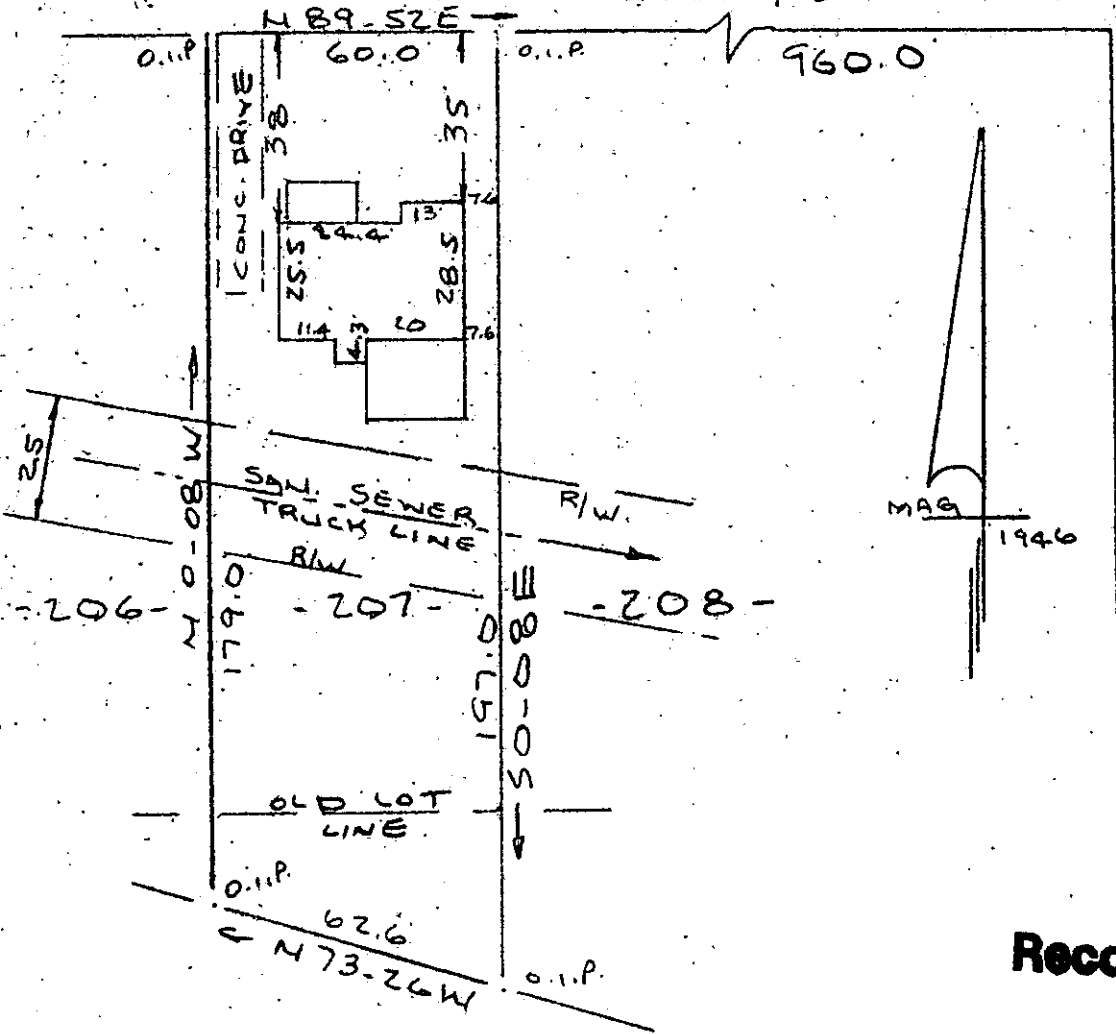


Note: Improvements on this lot are not in a flood hazard area.

Recordable Plat

PROPERTY OF  
JOHNNIE HOUSTON & GUYNELL G. HOUSTON  
GREENVILLE, S. C.

SCALE 1"=40 7 OCT 1983

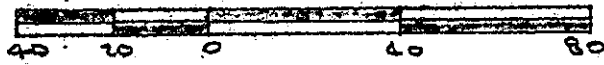

This is to certify that on the 7th day of October, 1983, I surveyed the property shown on this plat, being known as lot 207 on plat of PLEASANT VALLEY and recorded in the REC Office Greenville County, S. C., in Plat Book "P" at Page 75; and that the property lines, walls and buildings are as shown hereon, and that the walls and buildings located on said lot do not encroach or project on adjacent street or property, and that no adjacent walls or buildings encroach or project on said premises, and no power lines cross this property except as shown hereon. Also known as PROPERTY OF JOHNNIE HOUSTON & GUYNELL G. HOUSTON recorded in Plat Book at Page

*R. B. Bruce*  
R. B. Bruce, RLS #1952  
*R. B. Bruce*

FILED  
GREENVILLE CO. S.C.  
OCT 18 3 37 PM '83  
CAROLINA SURVEYING CO.  
112 Manly St.  
Greenville, S. C.

10-D-2

12785

1 OCT 18 83 708

3.0001