MICROFILMED

Note:
Improvements on this lot are not in a flood hazard area.

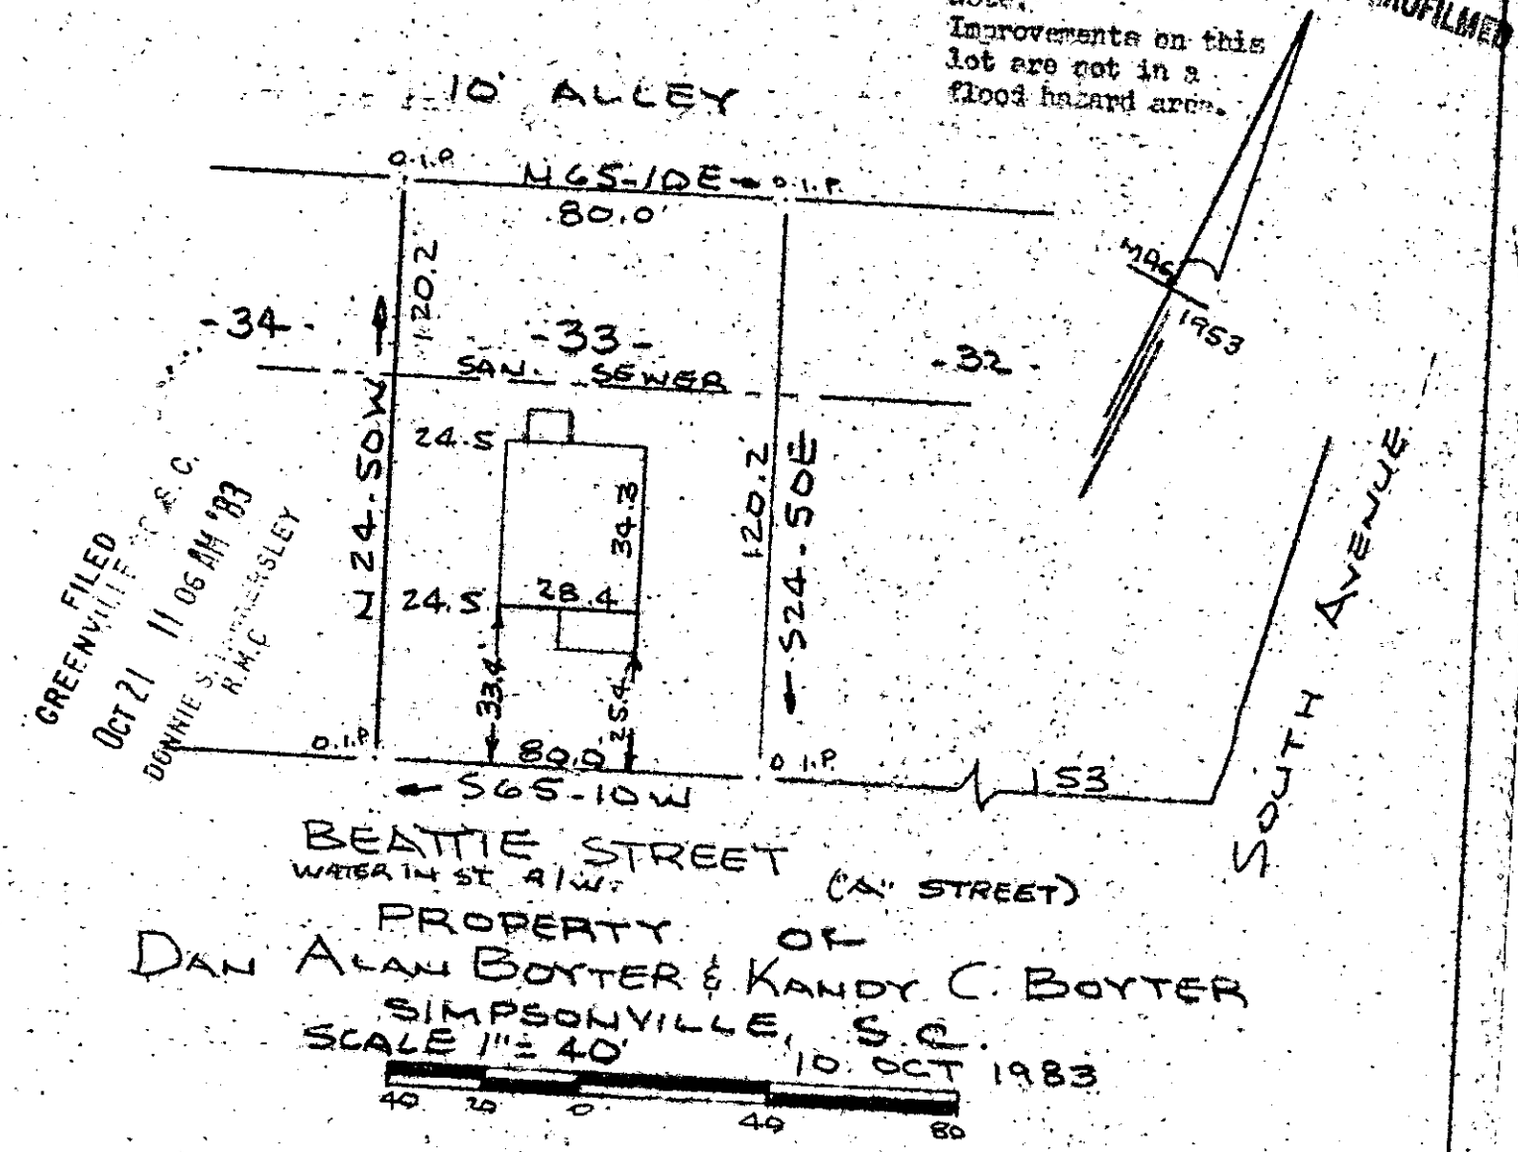

PROPERTY OF
DAN ALAN BOYTER & KANDY C. BOYTER
SIMPSONVILLE, S.C.
SCALE 1" = 40'
10 OCT 1983

40 20 0 40 80

This is to certify that on the 10th day of October, 1983, I surveyed the property shown on this plat, being known as lot 33 on plat of WOODSIDE MILLS and recorded in the RMC Office Greenville County, S. C., in Plat Book " GG " at Page 5; and that the property lines, walls and buildings are as shown hereon, and that the walls and buildings located on said lot do not encroach or project on adjacent street or property, and that no adjacent walls or buildings encroach or project on said premises, and no power lines cross this property except as shown hereon.

OCT 21 1983 ✓

10-D-23 **Recordable Plat**

R. B. Bruce, RLS #1952

13151 CAROLINA SURVEYING CO.
117 Manly Ct.
Greenville, S. C.

3.00CJ

2 OCT 21 83 930

261/27

324-2-3