


Note: Improvements on this lot are not in a flood hazard area.

PROPERTY OF
 LARRY T. DURHAM
 NEAR GREENVILLE, GREENVILLE COUNTY, S.C.
 18 OCT 1983

13301 ✓
 10-D-25

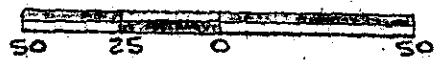

This is to certify that on the 18th day of October, 1983, I surveyed the property shown on this plat, being known as lot 15 and part of lot 16 on plat of J. ROWLEY YOUNG and recorded in the RMC Office Greenville County, S. C., in Plat Book : " II " at Pages 258 - 259 and also known as PROPERTY OF LARRY T. DURHAM and recorded in the RMC Office Greenville County, S. C., in Plat Book at Page ; and that the property lines, walls and buildings are as shown hereon, and that the walls and buildings located on said lot do not encroach or project on adjacent street or property, and that no adjacent walls or buildings encroach or project on said premises, and no power lines cross this property except as shown hereon.

Recordable Plat

R. B. Bruce
 R. B. Bruce, RLS #1952
 CAROLINA SURVEYING CO. AND SURVEYORS
 112 Main St. Greenville, S. C. 29601

CAROLINA SURVEYING CO.
 112 Main St. Greenville, S. C. 29601

264/8

242.2-2-3

MICROFILMED