

BONNIE YORK
PT 6

Note: Improvements on this lot are not in a flood hazard area.

SUMMIT DRIVE
WATER & SEWER IN ST. R/W


1350
S73-26W
RUTHERFORD ROAD
WATER & SEWER W. R/W

OCT 26 1983

10-D-34

PROPERTY OF
JOHN WILLIAM TOWNES
GREENVILLE COUNTY, GREENVILLE, S.C.
SCALE: 1"=40' 17 OCT 1983

13605

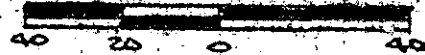

This is to certify that on the 17th day of October, 1983, I surveyed the property shown on this plat, being known as part of lot 6 on plat of MAP OF WEST CROFTSTOWN ACRES and recorded in the REC Office Greenville County, S. C., in Plat Book "E" at Page 36 and also being known as PROPERTY OF JOHN WILLIAM TOWNES and recorded in the REC Office Greenville County, S. C., in Plat Book _____ at Page _____; the property lines, walls and buildings are as shown hereon, and that the walls and buildings located on said lot do not overreach or project on adjacent street or property, and that no adjacent walls or buildings overreach or project on said premises, and no power lines cross this property except as shown hereon.

Recordable Plat

CAROLINA SURVEYING CO.
112 Hanly St.
Greenville, S. C.

R. B. Bruce
R. B. Bruce, RLS #1952

2002683 1335

3.0001