


FILED
 GREENVILLE CO. S.C.
 NOV 11 2 53 PM '83
 DONNIE STAMMERLEY
 R.M.C.

This is to certify that on November 11, 1983, I surveyed the property shown in this plat, known as Lot 37 on Plat of Barbrey Heights #2, recorded in the RMC Office of Greenville County in Plat Book BBB on Page 175, and that the property lines, walls and buildings are as shown hereon; that the building located on said lot does not encroach or project on adjacent streets or property, and that no adjacent walls or buildings encroach or project on said premises, and that no utility lines cross this property except as shown hereon. This property is not located in a designated flood hazard area.

James R. Freeland
 James R. Freeland RLS & PE 4781

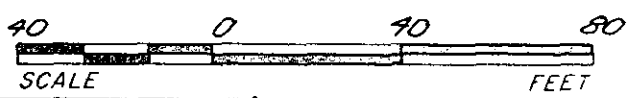

15737 ✓
 NOV 14 1983
 10-E-4



**STATE OF SOUTH CAROLINA
 GREENVILLE COUNTY**

BARBREY HEIGHTS #2
LOT 37
 PROPERTY OF
JERRY N. RIGGINS
MONTIE A. RIGGINS

FREELAND & ASSOCIATES
 Engineers • Land Surveyors
 GREENVILLE, S.C.

SURVEY	J.E.C.
DRAWN	K.E.G.
CHECK	M.C.
SCALE	1" = 40'
DATE	11-11-83
DWG. NO.	10041

GCTO --- 1 NO1483 429

11/11/83