


This is to certify that on November 11, 1983, I surveyed the property shown on this plat, known as Lot 79 on Plat of Devenger Pointe, Sec. 1, recorded in the RMC Office of Greenville County in Plat Book 9F on Page 59, and that the property lines, walls and buildings are as shown hereon; that the building located on said lot does not encroach or project on adjacent streets or property, and that no adjacent walls or buildings encroach or project on said premises, and that no utility lines cross this property except as shown hereon. This property is not located in a designated flood hazard area.

James R. Freeland
James R. Freeland RLS & PE
4781

NOV 21 1983

10E-19

✓ 16511

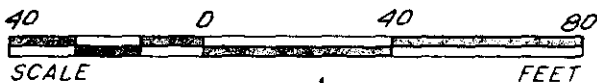

**STATE OF SOUTH CAROLINA
GREENVILLE COUNTY**

FREELAND & ASSOCIATES
Engineers • Land Surveyors

GREENVILLE, S.C.

DEVENGER POINTE

LOT 79, SEC. 1

PROPERTY OF

MARK C. ME KEE

WENDY C. ME KEE NO 22 83

SURVEY *B.G.*

DRAWN *B.R.*

CHECK *M.C.*

SCALE 1" = 40'

DATE *NOV. 11. 83*

DWG NO 10, 039

3.0000

