MICROFILMED

FILED
GREENVILLE CO. S. C.3
Nov 25 11 38 AM '83
DONNIE S. TANKERSLEY
R.M.C.

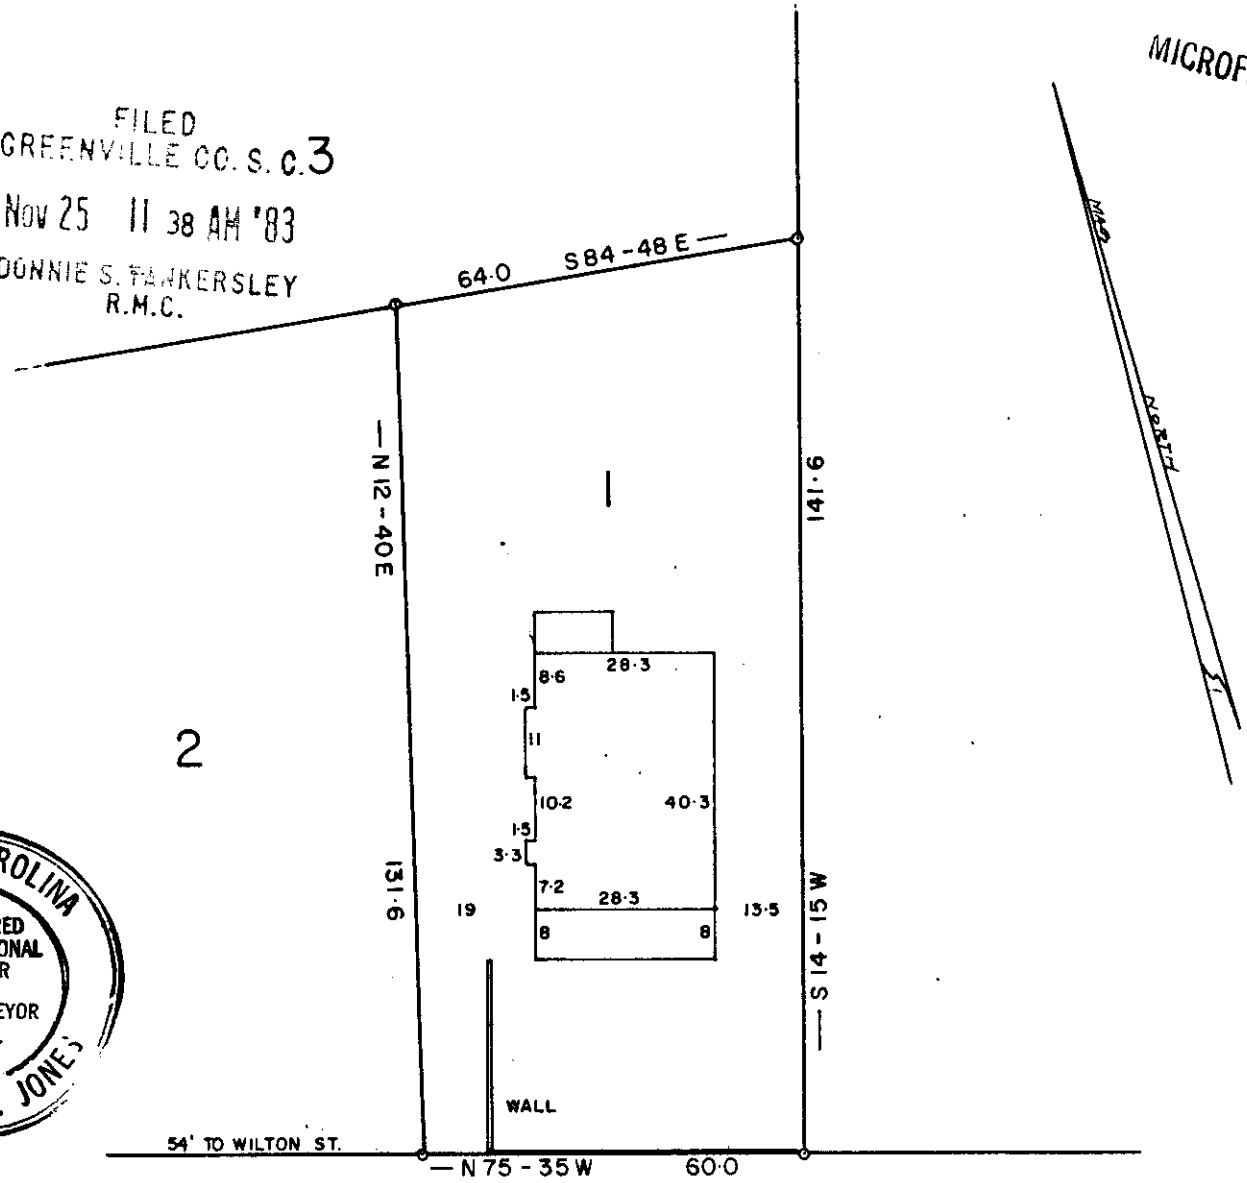

SOUTH CAROLINA
REGISTERED PROFFESSIONAL ENGINEER AND LAND SURVEYOR
1144
CLIFFORD C. JONES

SOUTH CAROLINA
REGISTERED ENGINEER
CLIFFORD C. JONES

NEAL STREET

NOTE: This lot does not lie in a flood plane.

NOV 25 1983

16950

10E-27

PROPERTY OF

WARD S. STONE JR.

GREENVILLE, S. C.

NOV. - 22 - 1983

0 10 20 30 SCALE 1" = 30' 100

This is to certify that on the 22 day of NOV 1983, I surveyed the property shown on the plat, being LOT 1 J.C. & R.H. LIGON PROP., recorded in Plat Book B 307A of the R.M.C. Office for Greenville County, S. C., and that the property lines, walls and buildings are as shown hereon; that the buildings located on said lot do not encroach or project on adjacent streets or property; and that no adjacent buildings or walls encroach or project on said premises, and that no utility lines cross this property.

Reg. Engineer No. 1144 S.C.

Jones Engineering Service 1006 East Perry Rd. Greenville, S. C. 29609