


This is to certify that on December 7,1983, I surveyed the property shown on this plat, known as Lot 21 on Plat of Leslie and Shaw Property, recorded in the RMC Office of Greenville County in Plat Book NN on Page 3, and that the property lines, walls and buildings are as shown hereon; that the building located on said lot does not encroach or project on adjacent streets or property, and that no adjacent walls or buildings encroach or project on said premises, and that no utility lines cross this property except as shown hereon. This property is not located in a

designated flood hazard area:

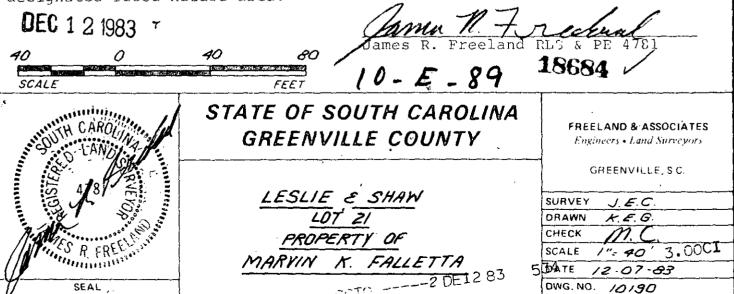

SECON CAL PAINT DAM TANK