

FILED
GREENVILLE CO. S. C.
DEC 21 3 48 PM '83
DONNIE S. TANKERSLEY
R.M.C.


DEC 21 1983

19767

10F-28

This is to certify that on June 14, 1983, I surveyed the property shown on this plat, known as Property of Redeemer Lutheran Church, recorded in the RMC Office of Greenville County in Deed Book 1011 on Page 836, and that the property lines, walls and buildings are as shown hereon; that the building located on said property does not encroach or project on adjacent streets or property, and that no adjacent walls or buildings encroach or project on said premises, and that no utility lines cross this property except as shown hereon. This property is not located in a designated flood hazard area.

James R. Freeland
James R. Freeland RLS & PE 4781

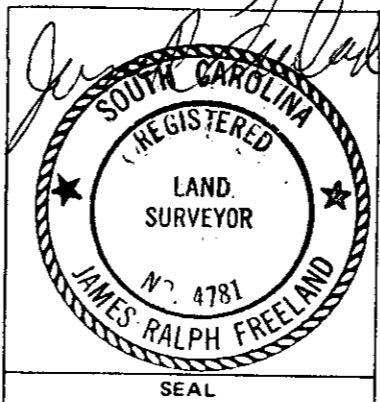

STATE OF SOUTH CAROLINA
GREENVILLE COUNTY

PROPERTY OF
REDEEMER LUTHERAN CHURCH

GCTO ---- 3 DE21 83

FREELAND & ASSOCIATES Engineers • Land Surveyors	
GREENVILLE, S.C.	
SURVEY	L.T.
DRAWN	B.R.
CHECK	M.C.
SCALE	1" = 100' 5.00CD
DATE	JUNE 14, 83
DWG. NO.	9138

MICROFILMED