
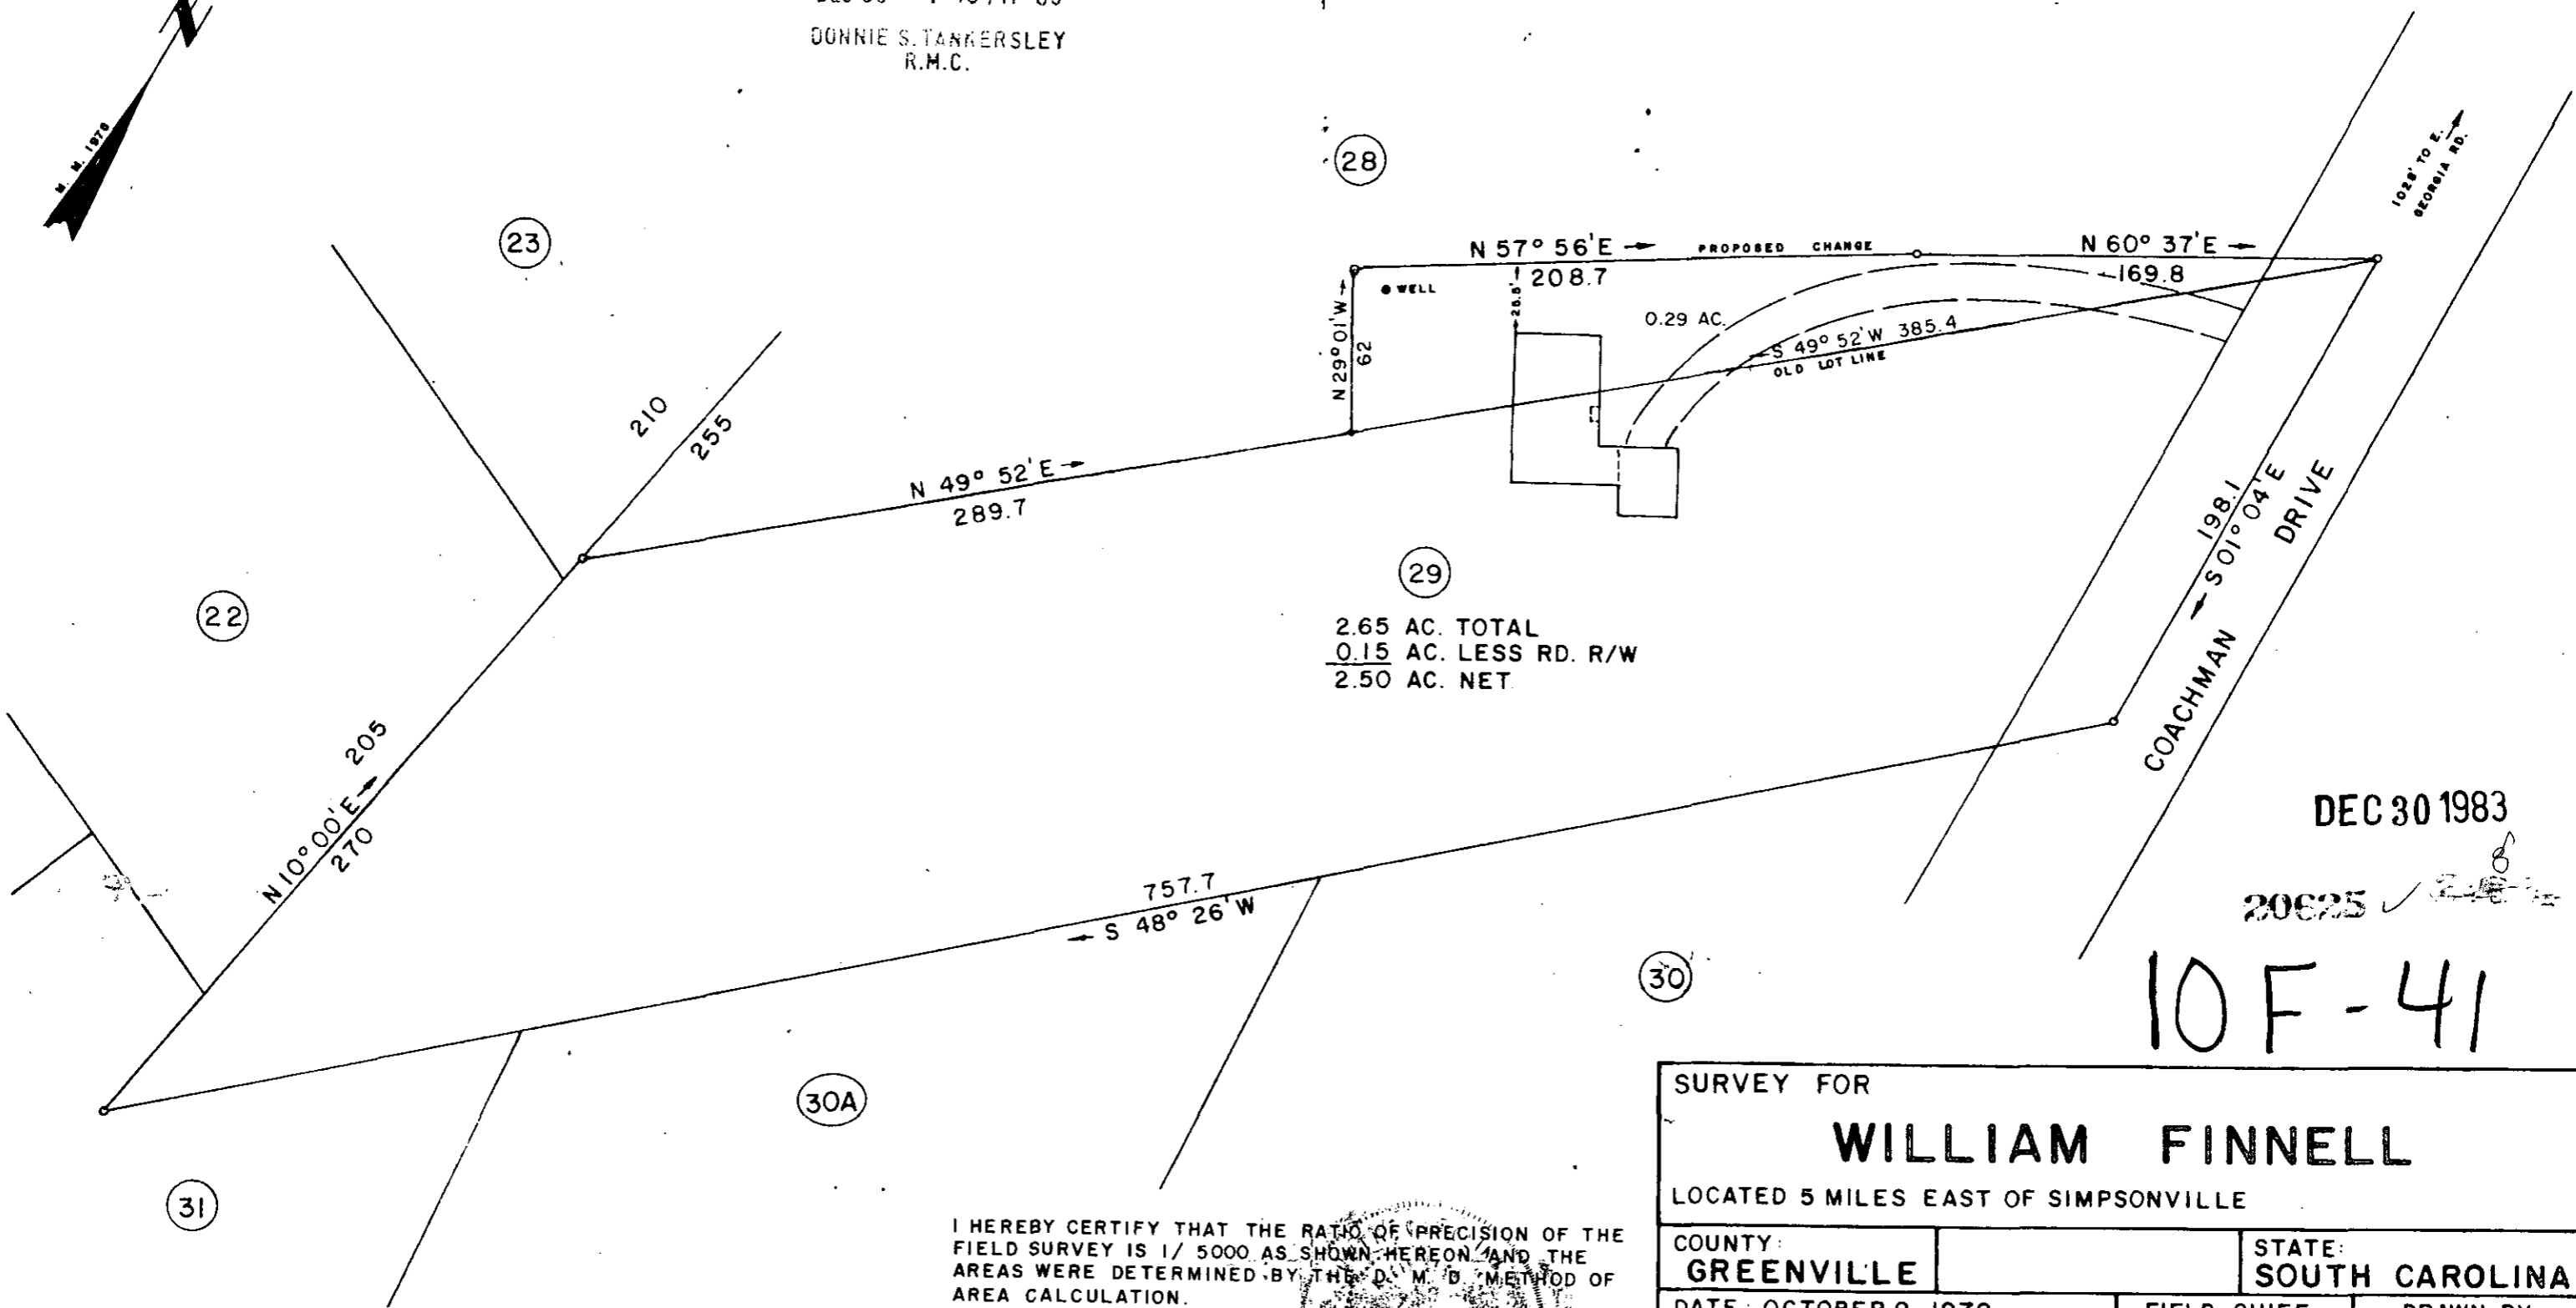


BEING LOT NO. 29, AS SHOWN ON PLAT OF COACHWOOD FOREST PHASE I DATED MARCH 1976, BY J. L. MONTGOMERY, III.

FILED  
GREENVILLE CO. S. C.  
Dec 30 4 46 PM '83  
DONNIE S. TANKERSLEY  
R.M.C.

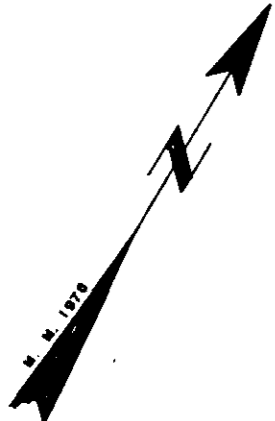


2.65 AC. TOTAL  
0.15 AC. LESS RD. R/W  
2.50 AC. NET

DEC 30 1983

20625 ✓

10F-41

I HEREBY CERTIFY THAT THE RATIO OF PRECISION OF THE FIELD SURVEY IS 1/ 5000 AS SHOWN HEREON AND THE AREAS WERE DETERMINED BY THE D. M. D. METHOD OF AREA CALCULATION.

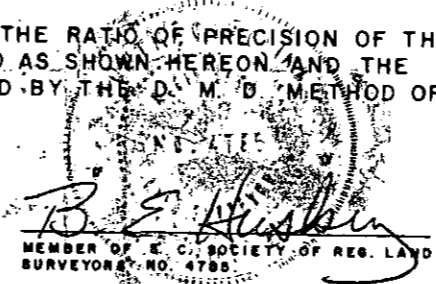

SURVEY FOR		
<b>WILLIAM FINNELL</b>		
LOCATED 5 MILES EAST OF SIMPSONVILLE		
COUNTY:	STATE:	
<b>GREENVILLE</b>	<b>SOUTH CAROLINA</b>	
DATE: OCTOBER 9, 1979	FIELD CHIEF	DRAWN BY
REVISED: DECEMBER 27, 1983	B. E. HUSKEY	L. B. MORROW
SCALE 1" = 60'		
WOLFE & HUSKEY, INC. ENGINEERING and SURVEYING P. O. BOX 35 LYMAN, S. C. 29365		

GCTD -- 1 DEC 30 83 760

5-9961

MICROFILMED