
400

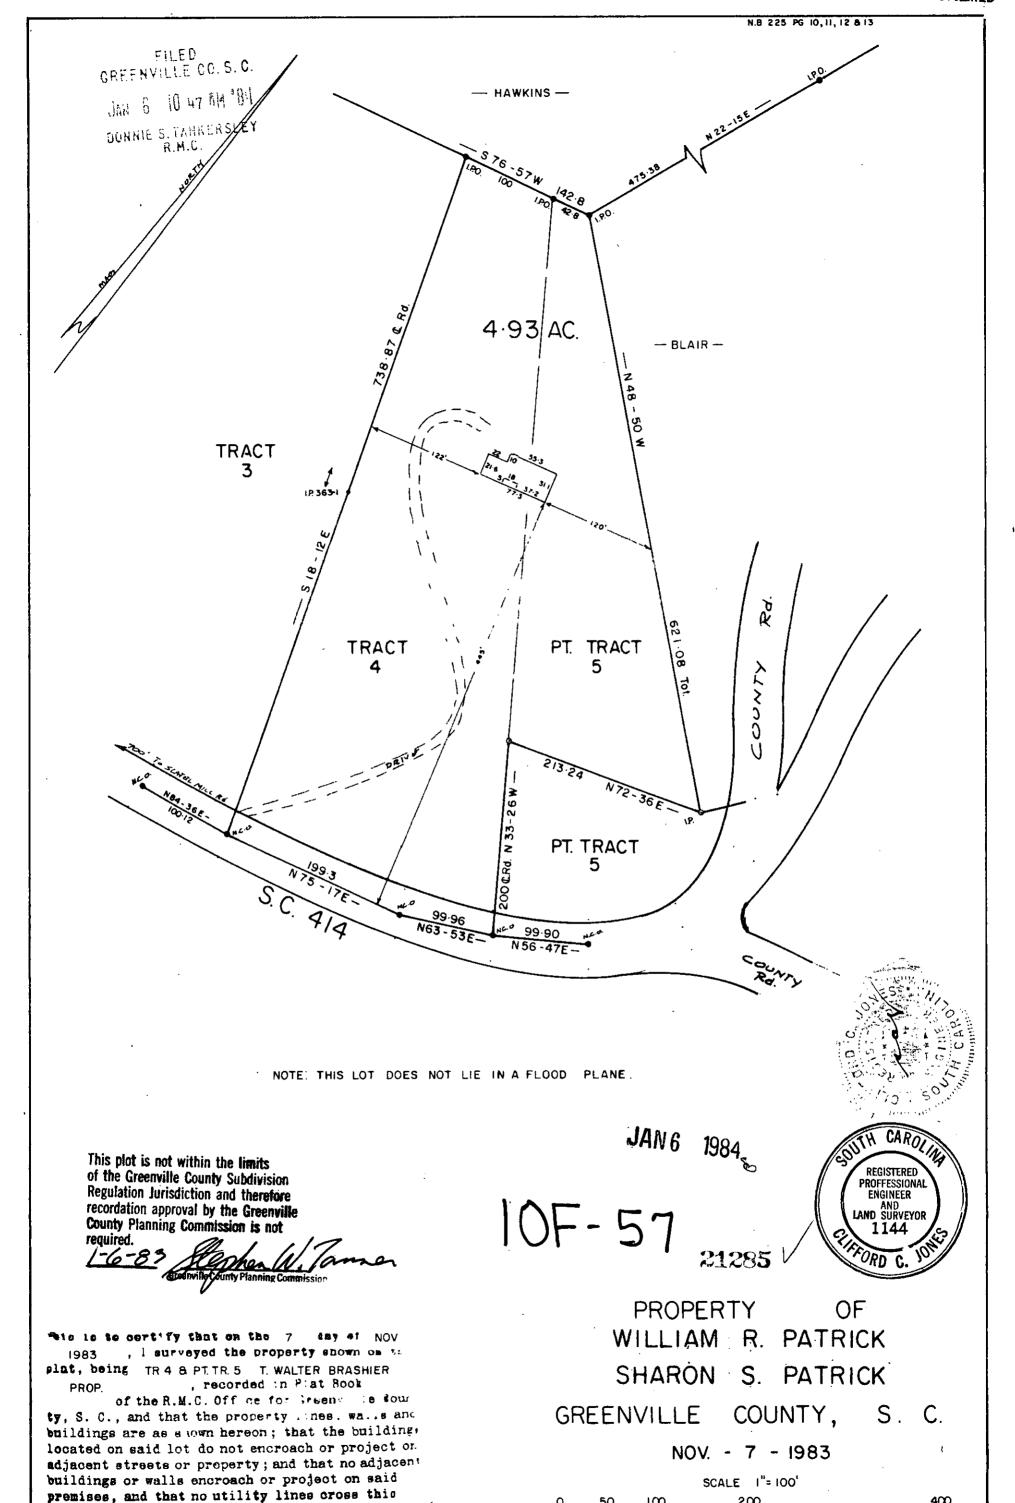


property.

50

100

200