


Note: This is Lot 13, Subdivision of Tract No. 1 Of Overbrook Land Co., Plat Book -K - Page 59.

FEB 1 2 14 PM '84

DONNIE S. TANKERSLEY R.M.C.

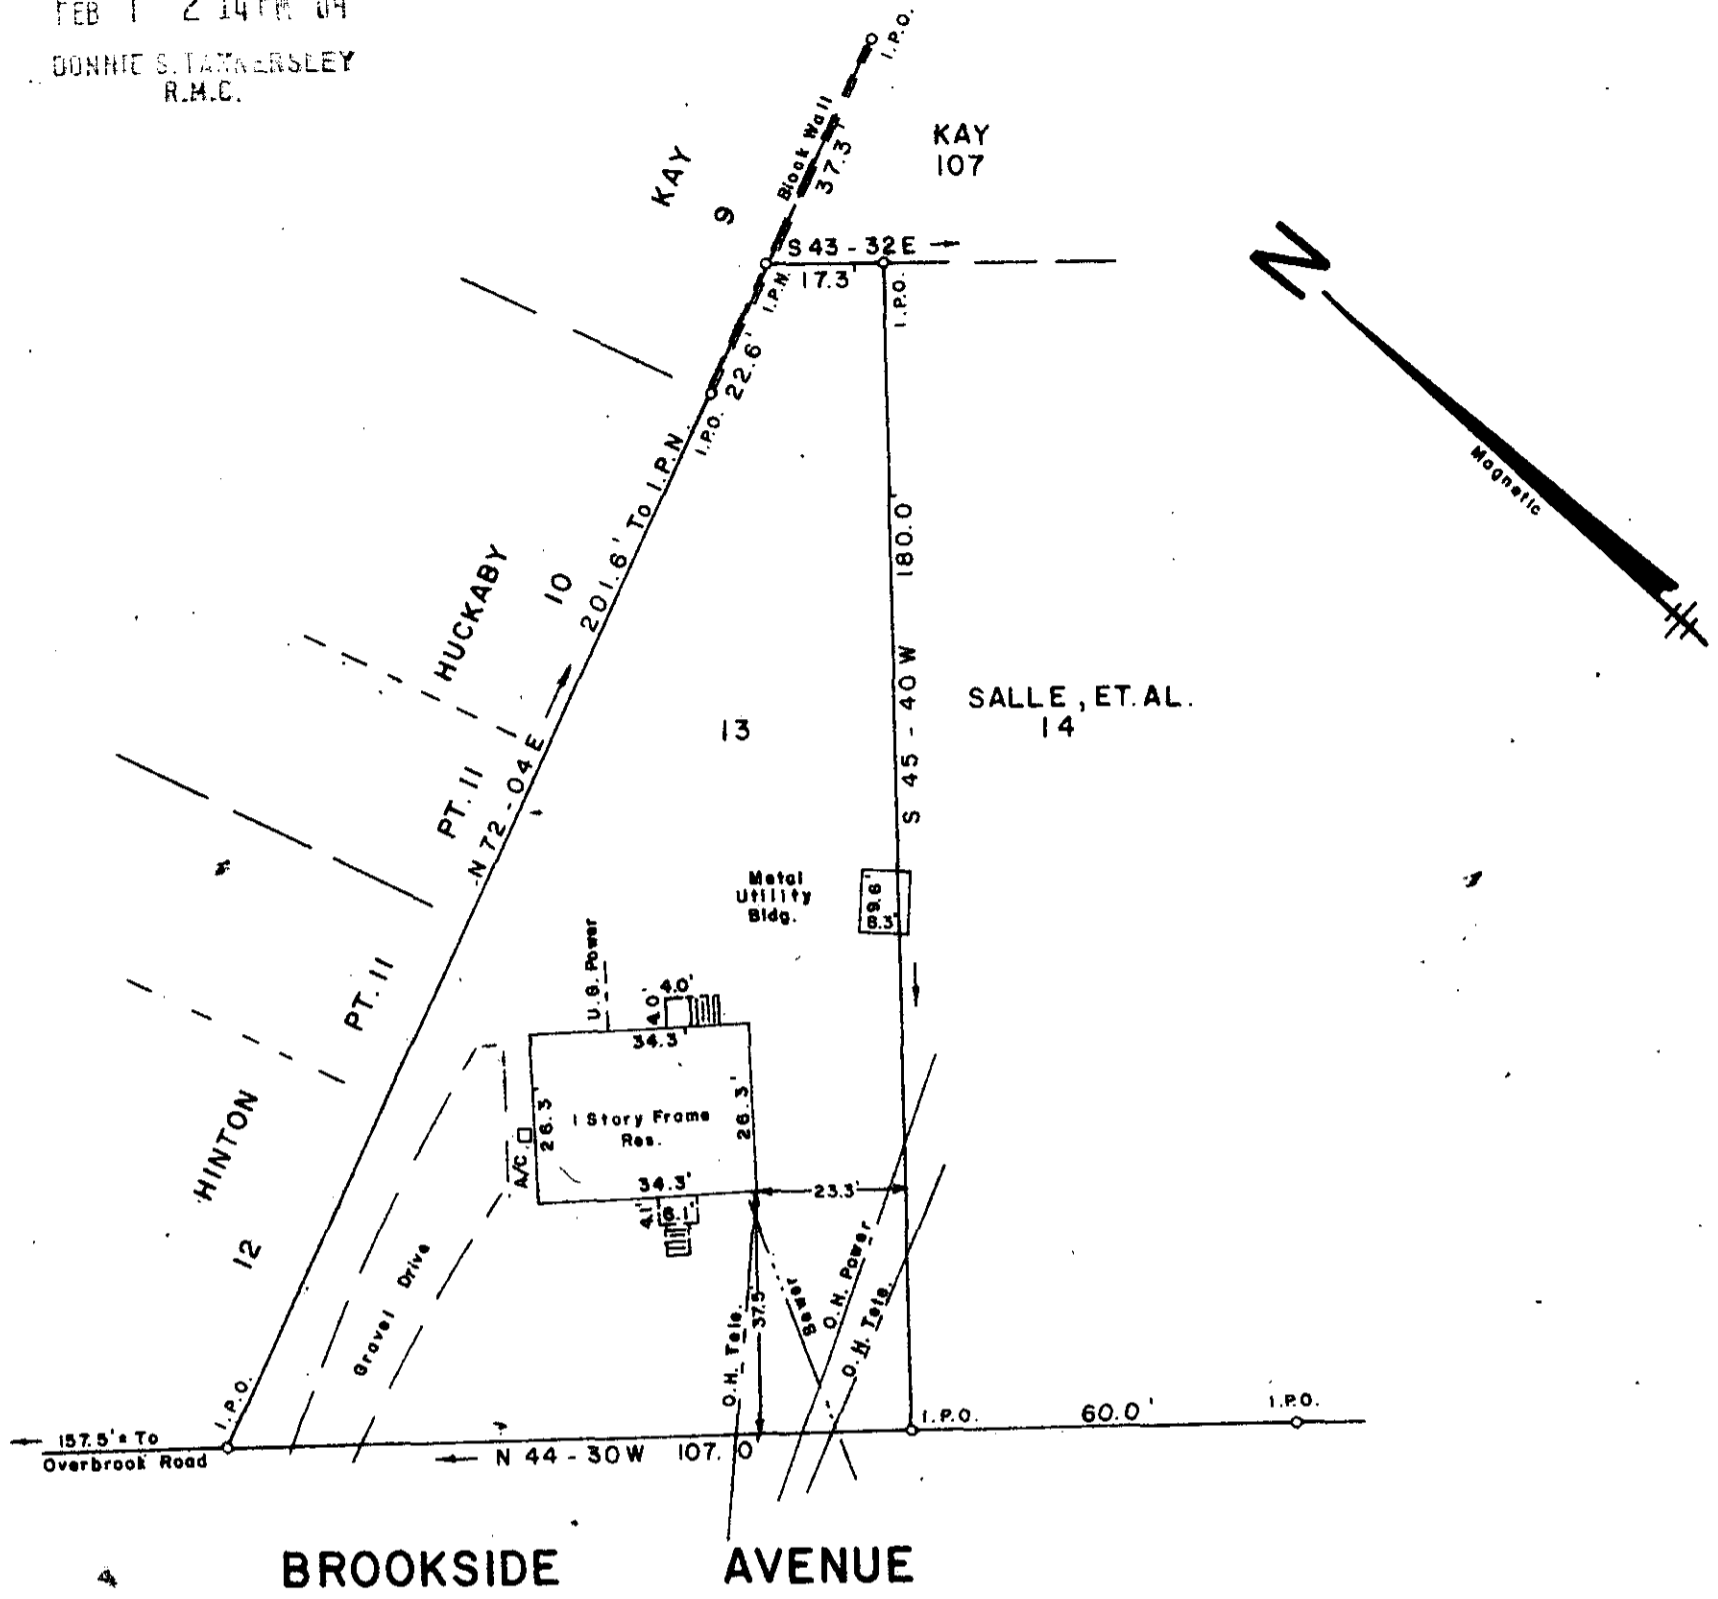

SURVEY FOR
RICHARD B. BACKLUND
ANTONIE P. BACKLUND

FEB 1 1984

CITY OF GREENVILLE GREENVILLE COUNTY
 SOUTH CAROLINA
 JANUARY 24, 1984

10-F-89
23819

I Hereby Certify That The Measurements As Shown Above Are Correct And There Are No Encroachments Or Projections Other Than Shown.

I Hereby Certify That The Ratio Of Precision Of The Field Survey Is 1/5000. As Shown Hereon And That Area Was Determined By D.M.D. Method.

To The Best Of My Knowledge This Structure Is Not In An Established Flood Zone.

JEFFERY M. PLUMBLEE, INC.
 LAND SURVEYING

P.O. BOX 788
 TRAVELERS REST, S. C. 29690 (803) 834-4428

Jeffery M. Plumblee
 REGISTERED PROFESSIONAL SURVEYOR
 P.L.S. #7881

Scale 1" = 30'

F.B. 18