

MICHAEL

GREENVILLE S.C.



DEC 21 2 02 PM '83

DONNIE S. TANKERSLEY
R.M.C.

- 5.11 AC ± GROSS -

SO PLANTATION PIPE LINE EASEMENT
N. 54-16 E
549.41 TOT

557.43 TOT
557-55 W

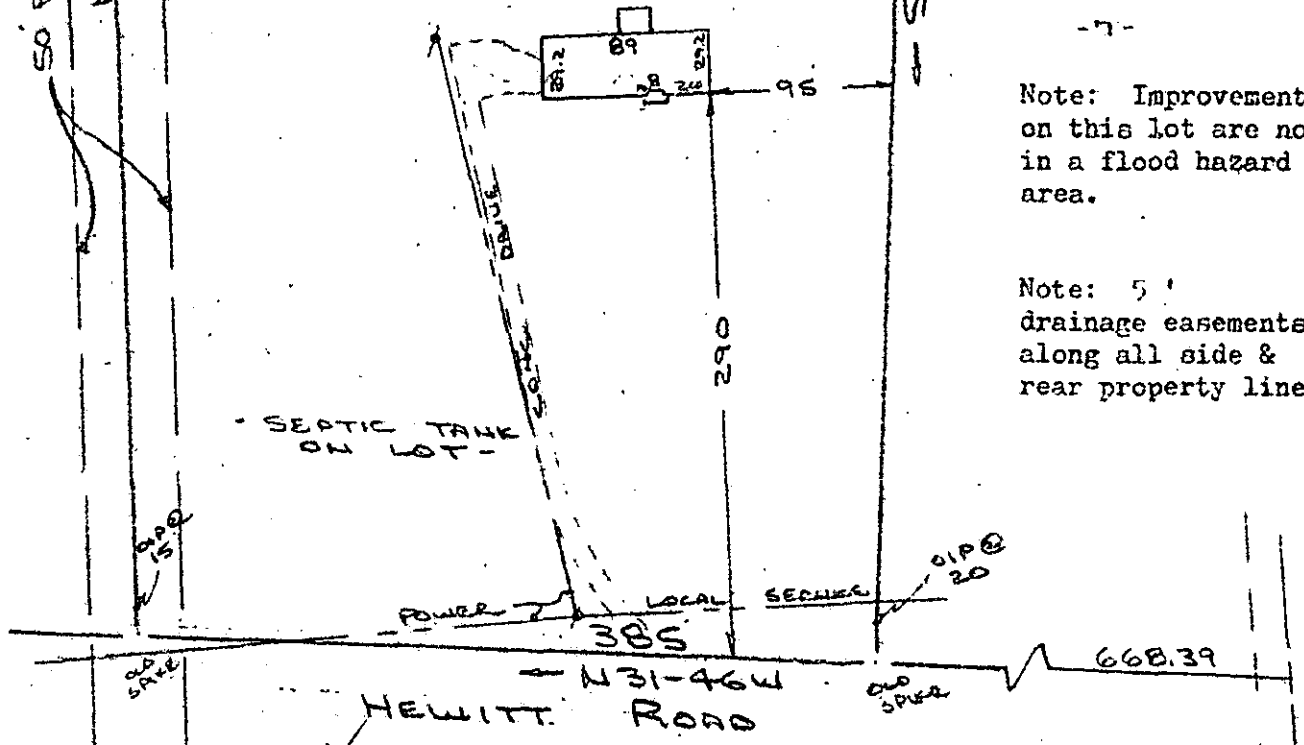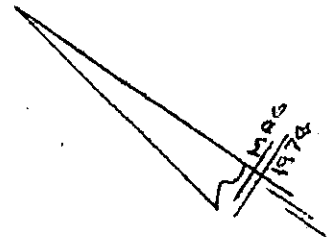


Note: Improvements on this lot are not in a flood hazard area.

Note: 5' drainage easements along all side & rear property lines.

19764

PROPERTY OF
RONALD O. BOHNERBERGER
NEAR FOUNTAIN INN, GREENVILLE COUNTY, S.C.
11 NOV 1983

10G-13

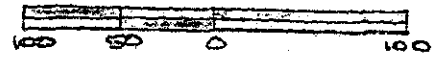

This is to certify that on the 11th day of November, 1983, I surveyed the property shown on this plat, being known as lot 8 (5.11 acres) on plat of CLUB VIEN RANCHETTES and recorded in the RMC Office Greenville County, S. C., in Plat Book " 5 - F " at Page 78; and that the property lines, walls and buildings are as shown hereon, and that the walls and buildings located on said lot do not encroach or project on adjacent street or property, and that no adjacent walls or buildings encroach or project on said premises, and no power lines cross this property except as shown hereon.

DEC 21 1983

CAROLINA SURVEYING CO.
112 GATEWAY ST.
Greenville, S. C.

R. B. [Signature]
R. B. [Signature]

3 DE 21 83R. 057ruce, RLS 193.0000