
MICROFILMED

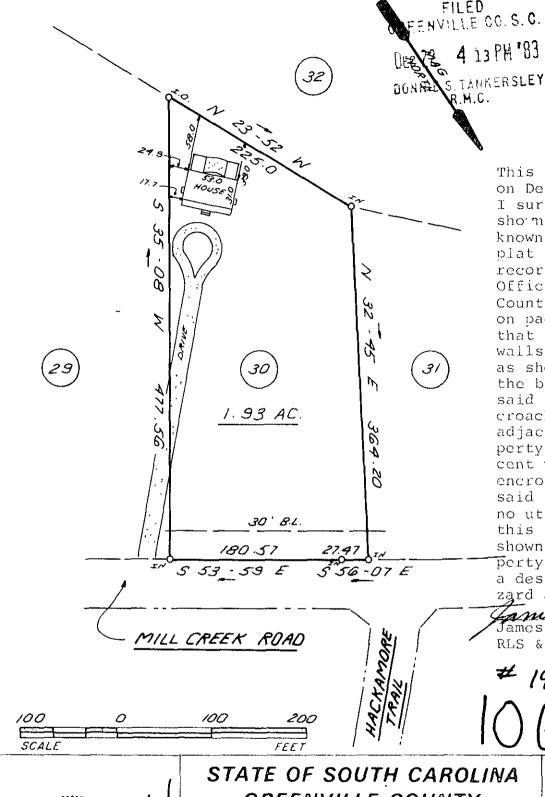

This is to certify that on December 21, 1983, I surveyed the property shorm on this plat, known as Lot 30 on the plat of Millcreek Estate. recorded in the RMC Office of Greenville County in Plat Book 4X on pages 87 & 88 and that the property lines, walls and buildings are as shown hereon; that the building located on said lot does not encroach or project on adjacent streets or property and that no adjacent walls or buildings encroach or project on said premises, and that no utility lines cross this property except as shown hereon. This property is not located in a designated flood hazard area.

RLS & PE 4781

DEC 22 1983

STATE OF SOUTH CAROLINA GREENVILLE COUNTY

> MILLCREEK ESTATE LOT 30 PROPERTY OF

MICHAEL STEHNEY ET. AL 3 DE22 83 FREELAND & ASSOCIATES Engineers . Land Surveyors

GREENVILLE, S.C.

SURVEY D.C.H. DRAWN K.E.G. CHECK  $m \subset$ SCALE "= 100

OSTATE ·12-21-83.00CD DWG. NO. 10253-2