


MICROFILMED

FILED
GREENVILLE CO. S. C.
DEC 30 4 00 PM '83
SUNNIE S. WALKERSLEY
R.M.C.

MAG
1925

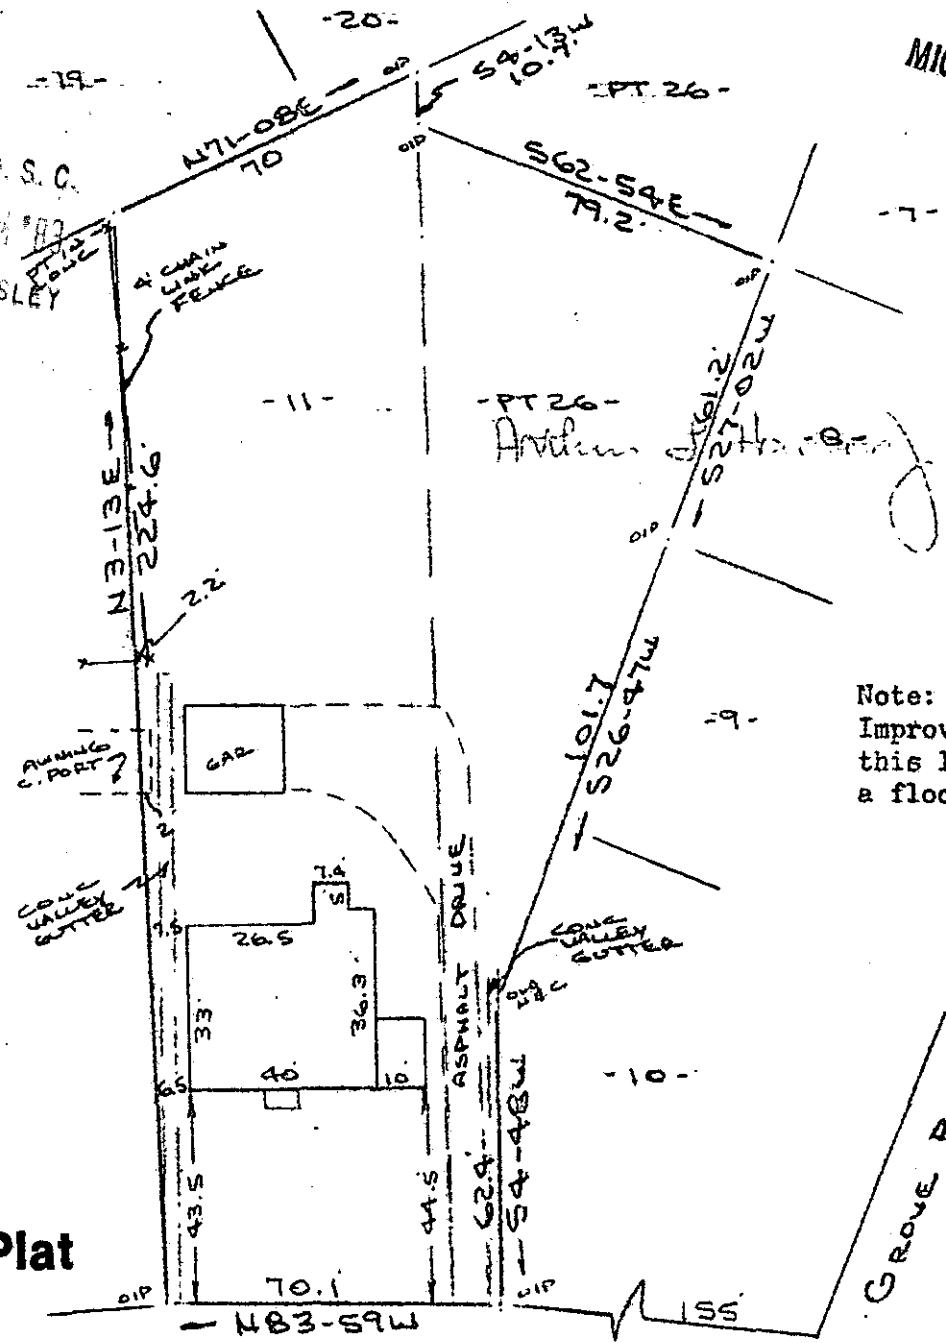

Note:
Improvements on
this lot are not in
a flood hazard area.

Recordable Plat

2 DE 30 83


515

3.0001

KIM STREET
WATER & SEWER IN ST R/W

10-G-43

PROPERTY OF
ELLIOTT NEIL WALKER & BETSY J. WALKER
GREENVILLE COUNTY, GREENVILLE, S.C. 20573 ✓
25 NOV 1983

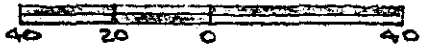

This is to certify that on the 25th day of November, 1983, I surveyed the property shown on this plat, being known as lot 11 and part of lot 26 on plat of BLOCK " O " PROPERTY OF O. P. MILLS and recorded in the RMC Office Greenville County, S. C., in Plat Book " F " at Page 299 and also known as PROPERTY OF ELLIOTT NEIL WALKER & BETSY J. WALKER recorded in Plat Book at Page ; and that the property lines, walls and buildings are as shown hereon, and that the walls and buildings located on said lot do not encroach or project on adjacent street or property, and that no adjacent walls or buildings encroach or project on said premises, and no power lines cross this property except as shown hereon.

R. E. Bruce
R. E. Bruce, RLS 1952

CAROLINA SURVEYING CO., 112 Manly St., Greenville, S. C.