MICROFILMED

FILED
GREENVILLE CO. S. C.
JAN 12 4 04 PM '84
DONNIE S. TANKERSLEY
R.M.C.

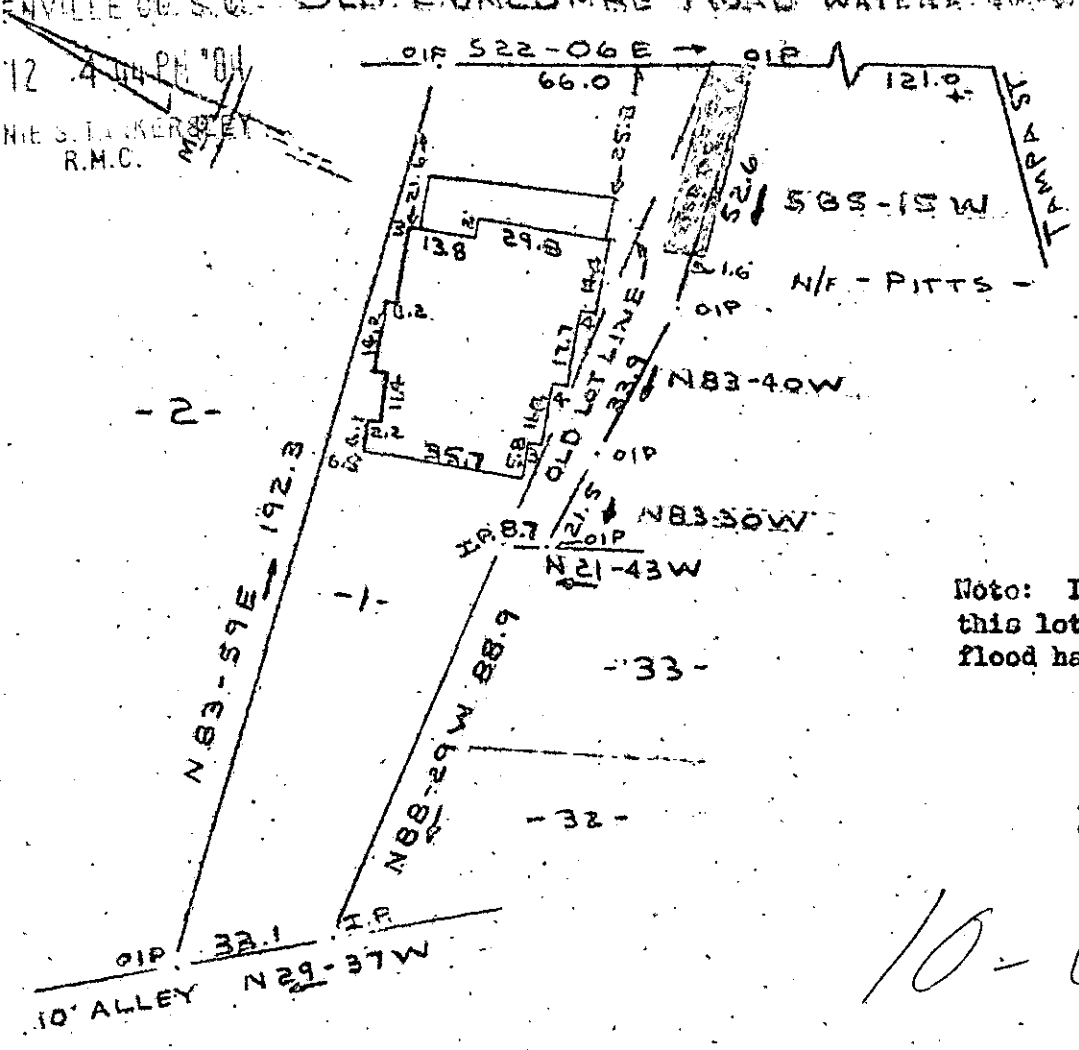

Note: Improvements on this lot are not in a flood hazard area.

21832 ✓

10-6-71

PROPERTY OF
NED A. FOSTER
NEAR GREENVILLE, S.C.
9 JAN 1984

40 20 0 40

JAN 12 1984

This is to certify that on the 9th day of January, 1984, I surveyed the property shown on this plat, being known as lot 1 on plat of MOUNTAIN VIEW LAND CO. and recorded in the RMC Office Greenville County, S. C., in Plat Book " A " at Pages 336 & 337 and also known as PROPERTY OF NED A. FOSTER and recorded in the RMC Office Greenville County, S. C., in Plat Book at Page ; and that the property lines, walls and buildings are as shown hereon, and that the walls and buildings located on said lot do not encroach or project on adjacent street or property, and that no adjacent walls or buildings encroach or project on said premises, and no power lines cross this property except as shown hereon.

R. D. Bruce

R. D. Bruce, RLS #1952

Recordable Plat

CAROLINA SURVEYING CO.
112 Manly St.
Greenville, S. C.

300-3 — 11A01

1ST-4-13