


FILED  
 GREENVILLE CO. S. C.  
 JAN 31 4 27 PM '84  
 DUNNIE R. M.C.  
 CANNERSLEY

PROPERTY OF  
 WILLIAM C. DORRIS  
 NEAR GREENVILLE, S.C.  
 SCALE: 1"=40' 23 FEB 1982

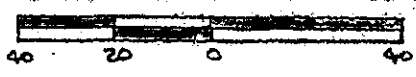

PLAT REV. 10 NOV 1983  
 TO SHOW NEW LOT  
 LINE ALONG SANFORD  
 D. PERRY PROPERTY

This is to certify that on the 23rd day of February, 1982, I surveyed the property shown on this plat, being known as part of lot 29 on plat of SURBURBAN LAND CO. of which is known as SANS SOUCI VILLA recorded in the RMC Office Greenville County, S. C., in Flat Book " A " at Pages 510 & 511; and that the property lines, walls and buildings are as shown hereon, and that the walls and buildings located on said lot do not encroach or project on adjacent street or property, and that no adjacent walls or buildings encroach or project on said premises, and no power lines cross this property except as shown hereon.

**Recordable Plat**

23642 ✓

*R. B. Brugg*  
 R. B. Brugg, PLS #1952  
*R. B. Brugg*

CAROLINA SURVEYING CO.  
 112 Manly St.  
 Greenville, S. C.

10-H-23