

NORTH PHOENIX ROAD


752 ±

160-29 W
174.5

PHILLIPS TRAIL
WATER IN
219.0

1954-295
232-1-262

0190/12
1948

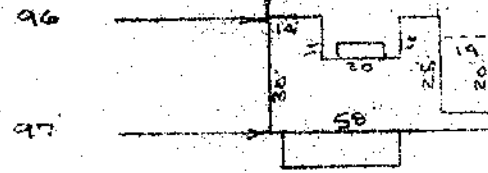

-26-

-1.05 AC-

- SEPTIC TANK ON LOT -

OIP


239.2
542-50 W

- KATE R. BREWER -

OIP

H/F
- APPERSON -

PROPERTY OF
CHARLES M. ROBINSON
NEAR GREENVILLE, GREENVILLE COUNTY, S.C.
14 FEB 1984

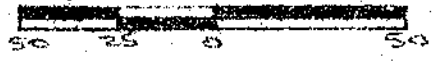

This is to certify that on the 14th day of February, 1984, I surveyed the property shown on this plat, being known as lot 26 on plat of A SUBDIVISION FOR LEE F. RAMSEY and recorded in the RMC Office Greenville County, S. C., in Plat Book " S " at Page 117 and also known as PROPERTY OF CHARLES M. ROBINSON and recorded in Plat Book " S " at Page 113; and that the property lines, walls and buildings are as shown hereon, and that the walls and buildings located on said lot do not encroach or project on adjacent street or property, and that no adjacent walls or buildings encroach or project on said premises, and no power lines cross this property except as shown hereon.

Recordable Plat

FEB 16 1984

25265 ✓

R. B. Bruce
R. B. Bruce, RLS # 1952

CAROLINA SURVEYING CO.
112 Manly St.
Greenville, S. C.

10-H-62

FILED
GREENVILLE CO. S. C.
FEB 16 10 28 AM '84
CONNIE STANBURY
R.M.C.
SCTD --- 1 FEB 1984 113

3.00CT

MICROFILMED

262/14 261/65

460-1-34