



MICROFILMED

FILED
GREENVILLE CO. S.C.
FEB 23 4 24 PM '84
DONNIE S. TANKERSLEY
R.M.C.

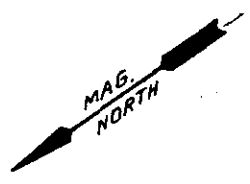

LOT 15

LOT 18

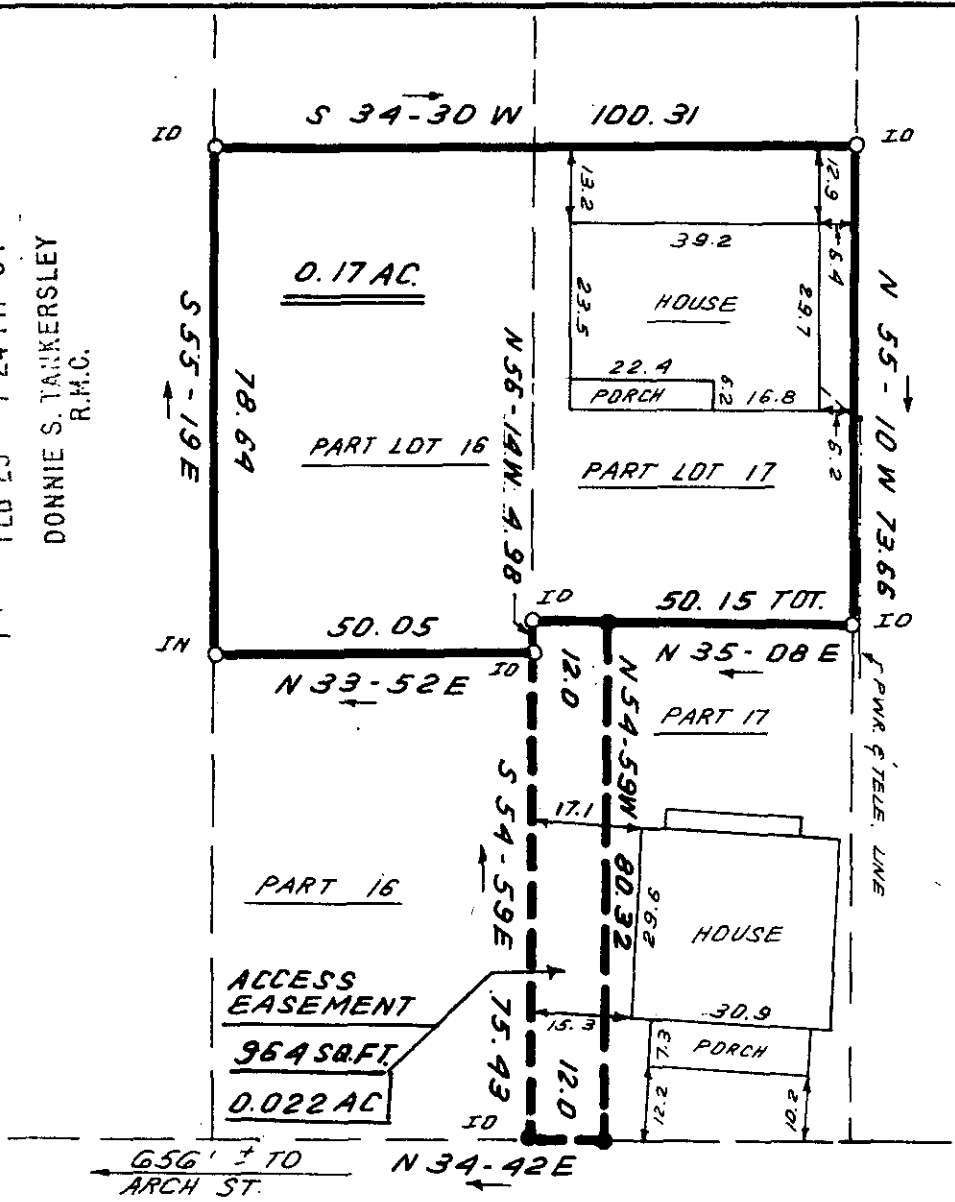

656' ± TO ARCH ST.
GENTRY ST.



10-H-92

25965

THIS IS TO CERTIFY THAT THE PROPERTY SHOWN ON THIS PLAT WAS SURVEYED UNDER MY DIRECT SUPERVISION. PROPERTY LINES AND IMPROVEMENTS SHOWN ARE LOCATED CORRECTLY AND THAT NO VISIBLE ENCROACHMENTS EXIST UNLESS OTHERWISE SHOWN. THIS PROPERTY IS NOT LOCATED IN A DESIGNATED FLOOD HAZARD AREA.

STATE OF SOUTH CAROLINA
GREENVILLE COUNTY

FREELAND & ASSOCIATES
Engineers • Land Surveyors
318 WEST STONE AVENUE.
GREENVILLE, S.C.
(803) 271-4924

PROPERTY OF
JUSHAW W. BUCHANAN
HELEN L. BUCHANAN

PLAT BOOK	F-166
DEED BOOK	1107-104 & 105
TAX MAP	235-4-30
PARTY CHIEF	B.G.
DRAWN	B.R.
DATE	FEB. 20. 84
DWG. NO.	10, 3500CD

RLS: JAMES R. FREELAND
NO: 4781

GCTO -----3 FE23 84 070