AF 10755A

MICROFILMED

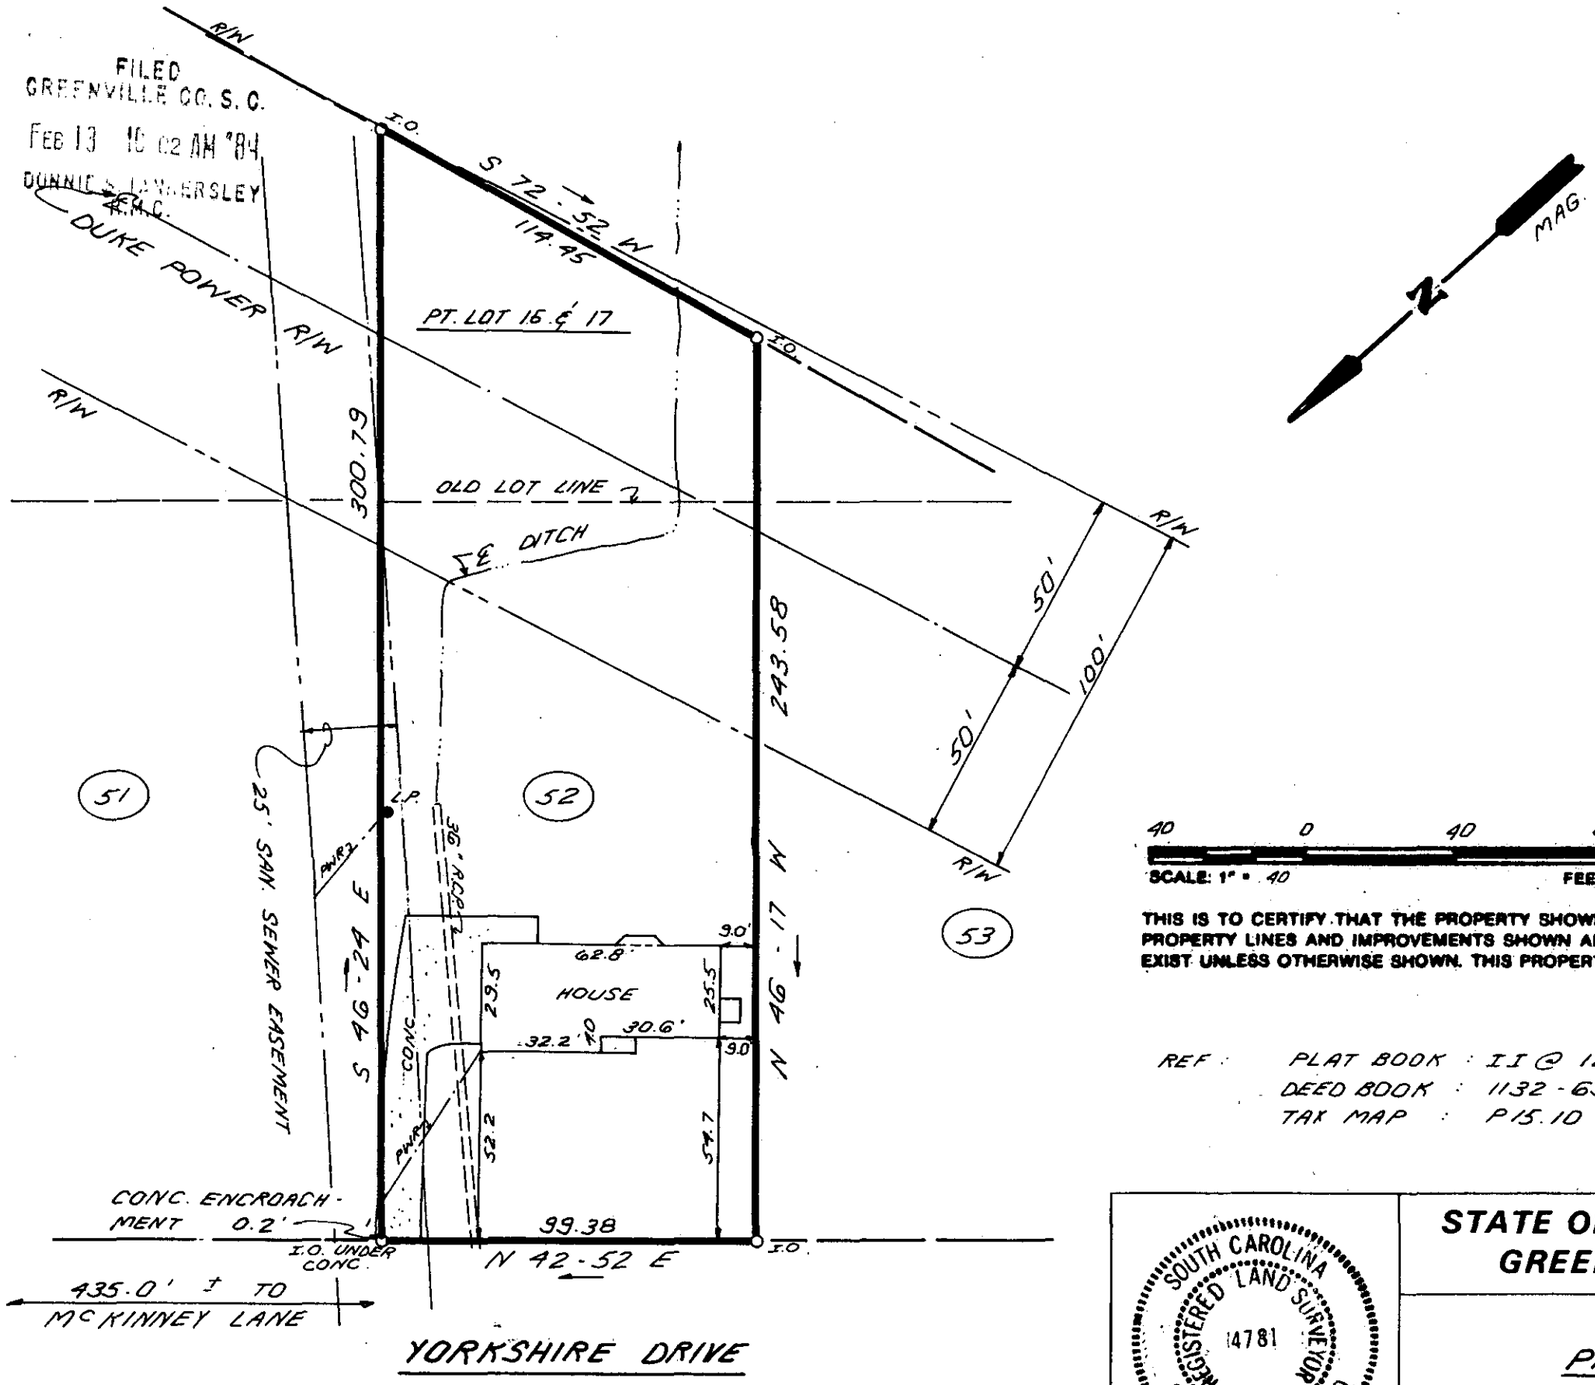

FILED
GREENVILLE CO. S. C.
FEB 13 10 02 AM '84
DONNIE S. TANKERSLEY
R.M.C.

10-I-5

FEB 13 1984 24842

40 0 40 80
SCALE: 1" = 40 FEET

THIS IS TO CERTIFY THAT THE PROPERTY SHOWN ON THIS PLAT WAS SURVEYED UNDER MY DIRECT SUPERVISION. PROPERTY LINES AND IMPROVEMENTS SHOWN ARE LOCATED CORRECTLY AND THAT NO VISIBLE ENCROACHMENTS EXIST UNLESS OTHERWISE SHOWN. THIS PROPERTY IS NOT LOCATED IN A DESIGNATED FLOOD HAZARD AREA.

REF: PLAT BOOK : II @ 121 & 48 @ 153
DEED BOOK : 1132-691 & 1132-625
TAX MAP : P15.10-1-161

SOUTH CAROLINA REGISTERED LAND SURVEYOR 4781 JAMES R. FREELAND
SEAL

STATE OF SOUTH CAROLINA
GREENVILLE COUNTY

PROPERTY OF
BETTY Y. JACKSON

GCTO -----3 FE13 84 OOT 5.00CD

FREELAND & ASSOCIATES
Engineers • Land Surveyors
GREENVILLE, S.C.

SURVEY	L.T.
DRAWN	R.E.G.
CHECK	WSHF
SCALE	1" = 40'
DATE	FEB. 7, 1984
DWG. NO.	10475