


HUNTINGTON LAKE

HUNTINGTON

PROPERTY LINE IS WATER LEVEL
(D.B. 686-229)

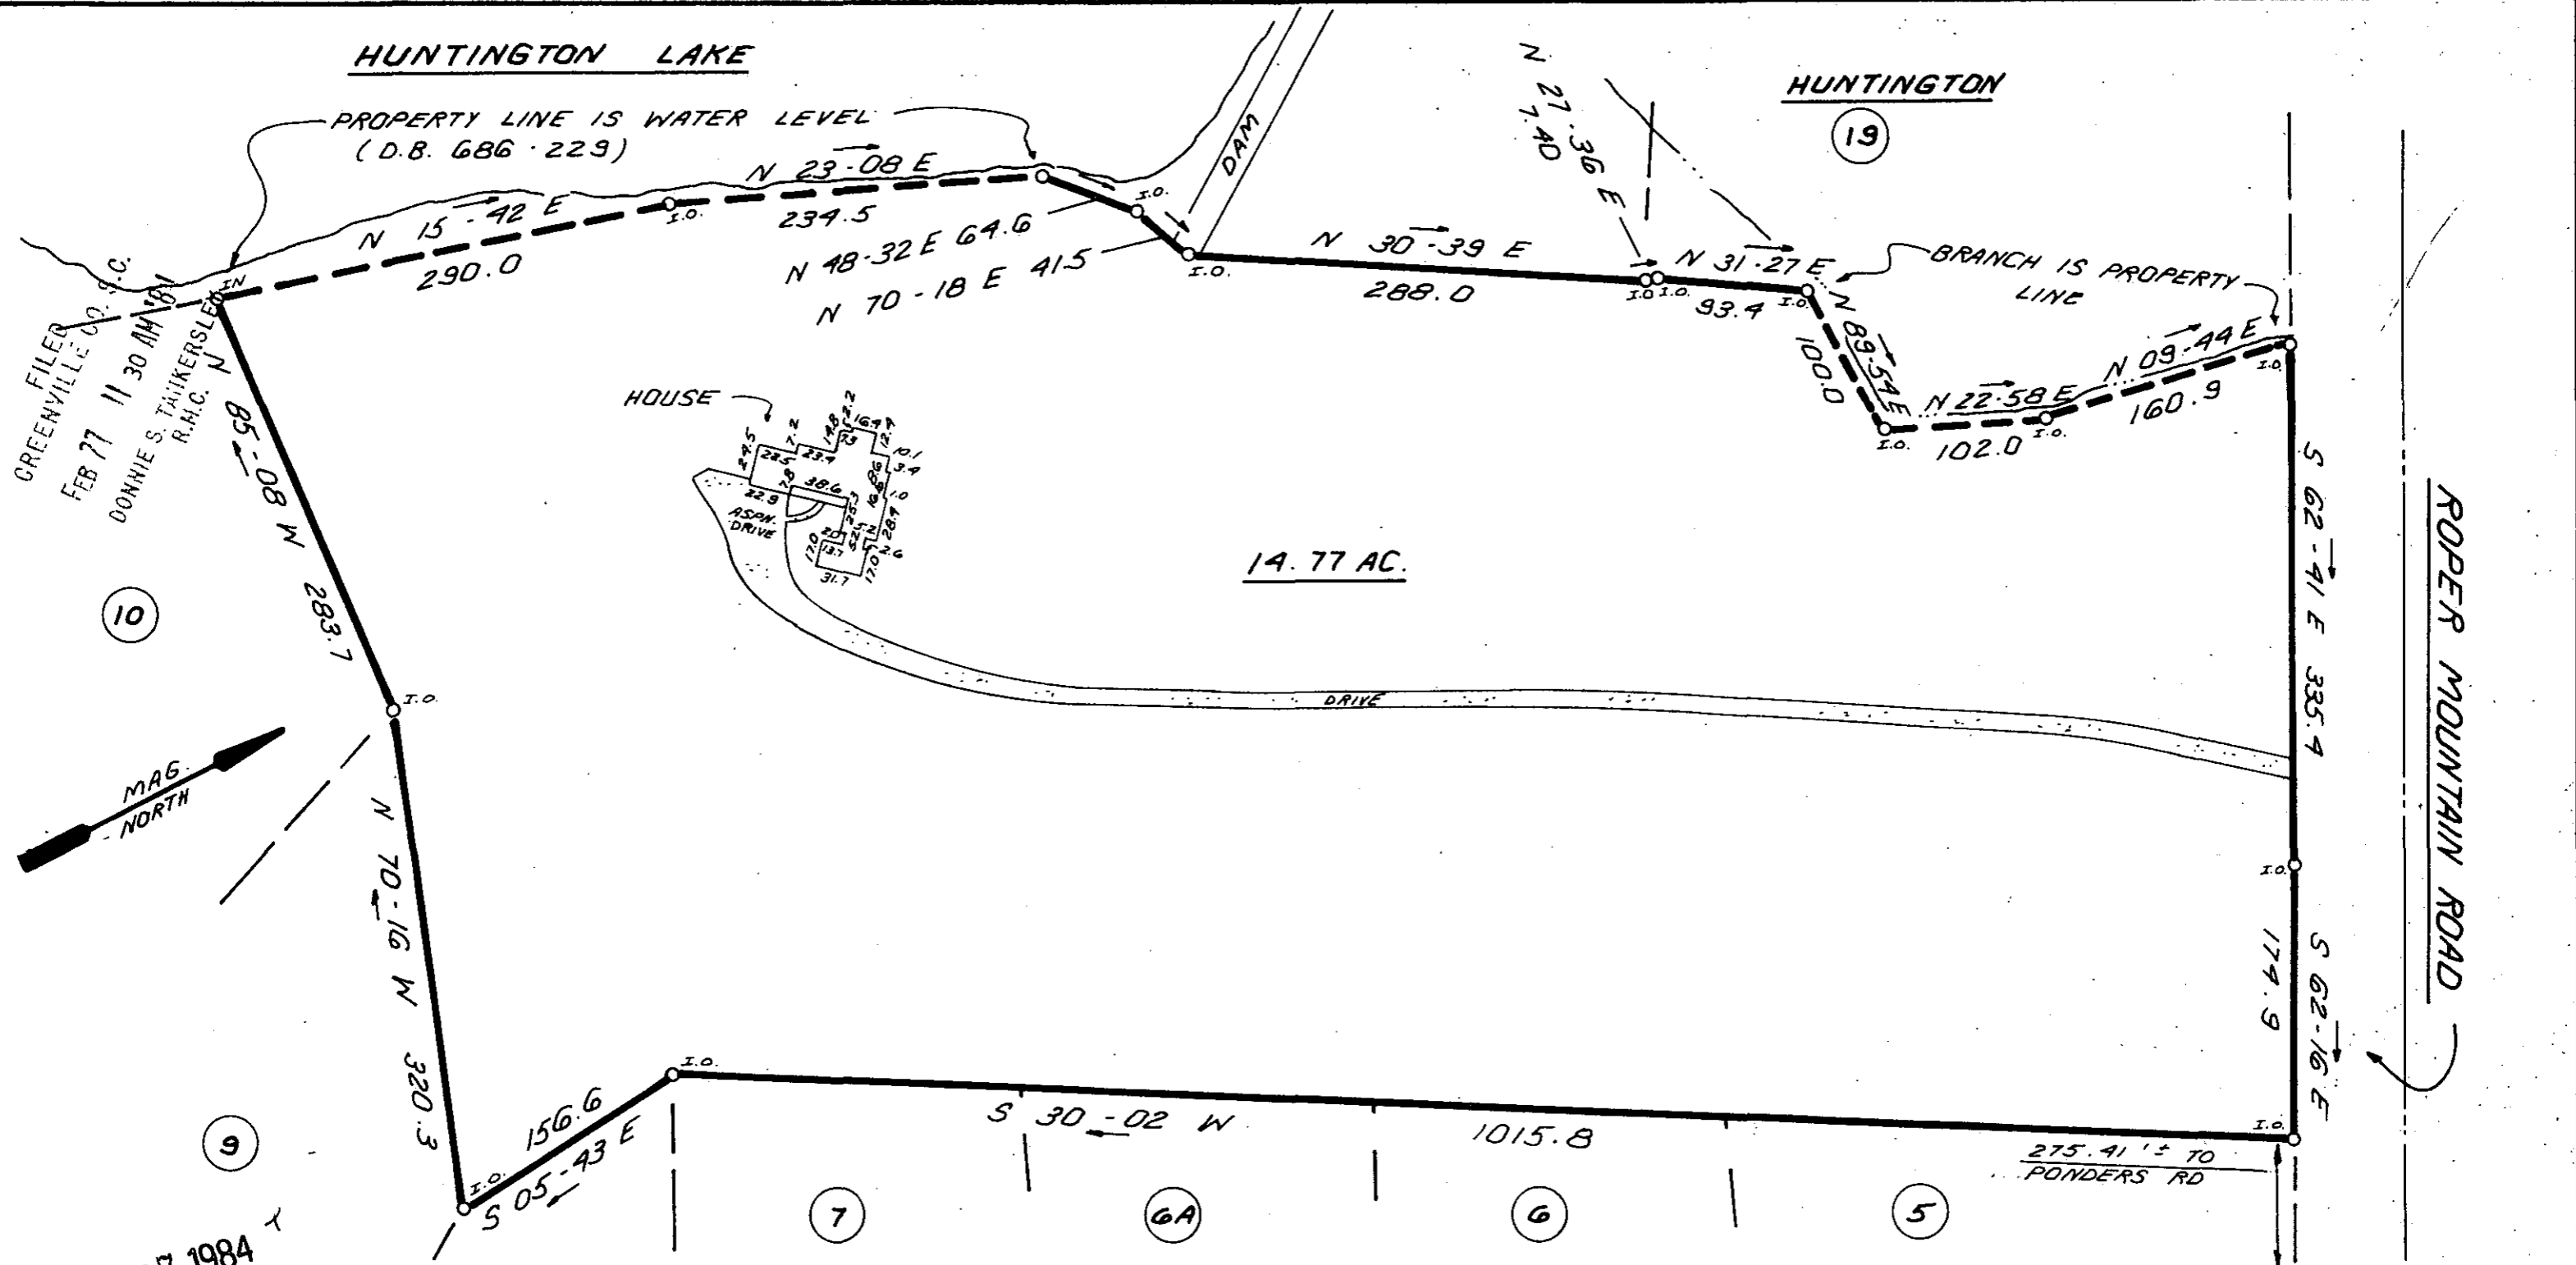


14.77 AC.

FEB 27 1984

HUNTINGTON

PLAT BOOK WVN-29 & 27
DEED BOOK 1012-253
TAX MAP 547.9-1-81 & 81.1

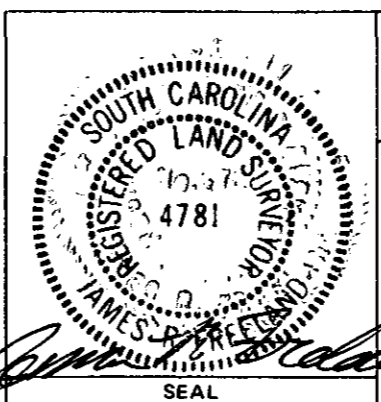

STATE OF SOUTH CAROLINA
GREENVILLE COUNTY

26234 ✓
SURVEY FOR
GEORGE M. PLYLER

10-I-23

FREELAND & ASSOCIATES Engineers • Land Surveyors	
GREENVILLE, S.C.	
SURVEY	M.L.C.
DRAWN	K.E.G.
CHECK	M.C.
SCALE	1" = 100'
DATE	1-11-84
DWG. NO.	10333

This is to certify that the property shown on this plat was surveyed under my direct supervision. Property lines and improvements shown are located correctly and that no visible encroachments exist unless otherwise shown. This property is not located in a designated flood hazard area.

MICROFILMED