

FILED
GREENVILLE CO. S.C.

MAR 7 4 25 PM '84

BONNIE S. SANKERSLEY


(17)

381.1
S 71° 24' W

(15)

(16)
3.08 ACRES


S 71° 22' E
425.8

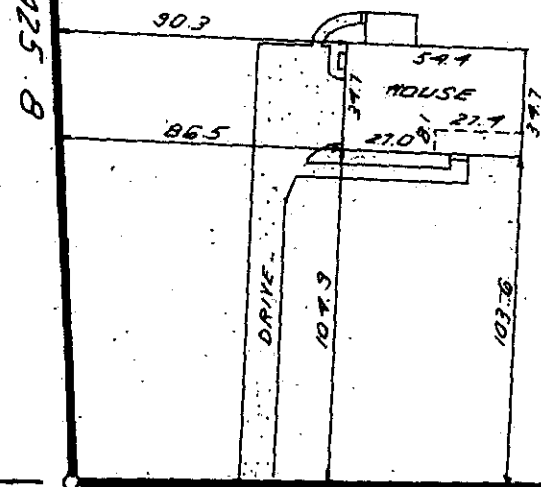

95.0
N 53° 06' W
294.4
N 67° 39' W
35.4
N 22° 52' W

OAK CREST COURT

N 21° 41' E 300.0
SHAGBARK CIRCLE

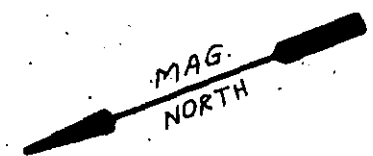


NOTE: THERE IS A 5' DRAINAGE & UTILITY EASEMENT EACH SIDE ALL SIDE & REAR LOT LINES.


MAR 7 1984

27464

10-I-31

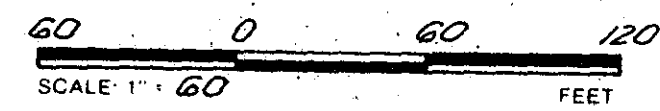

THIS IS TO CERTIFY THAT THE PROPERTY SHOWN ON THIS PLAT WAS SURVEYED UNDER MY DIRECT SUPERVISION. PROPERTY LINES AND IMPROVEMENTS SHOWN ARE LOCATED CORRECTLY AND THAT NO VISIBLE ENCROACHMENTS EXIST UNLESS OTHERWISE SHOWN. THIS PROPERTY IS NOT LOCATED IN A DESIGNATED FLOOD HAZARD AREA.

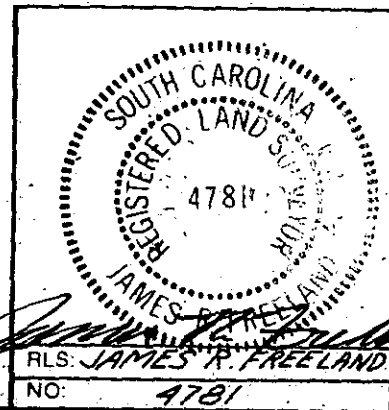

STATE OF SOUTH CAROLINA
GREENVILLE COUNTY

FAIRVIEW WOODS
SHEET 1, LOT 16
PROPERTY OF
GEOFFREY A. KRUG
LENNIS B. KRUG

FREELAND & ASSOCIATES
Engineers • Land Surveyors
318 WEST STONE AVENUE,
GREENVILLE, S.C.
(803) 271-4924

PLAT BOOK	50-82
DEED BOOK	1000-843
TAX MAP	5685-1-50
PARTY CHIEF	B.C.
DRAWN	K.E.G.
DATE	MARCH 2, 1984
DWG. NO.	180637

MICROFILMED

THE PRINT MACHINE, INC. N41289