


FILED
GREENVILLE CO. S.C.

CAROLDEAN CIRCLE


MAR 8 11 27 AM '84
DONNIE S. TANKERSLEY
R.M.C.

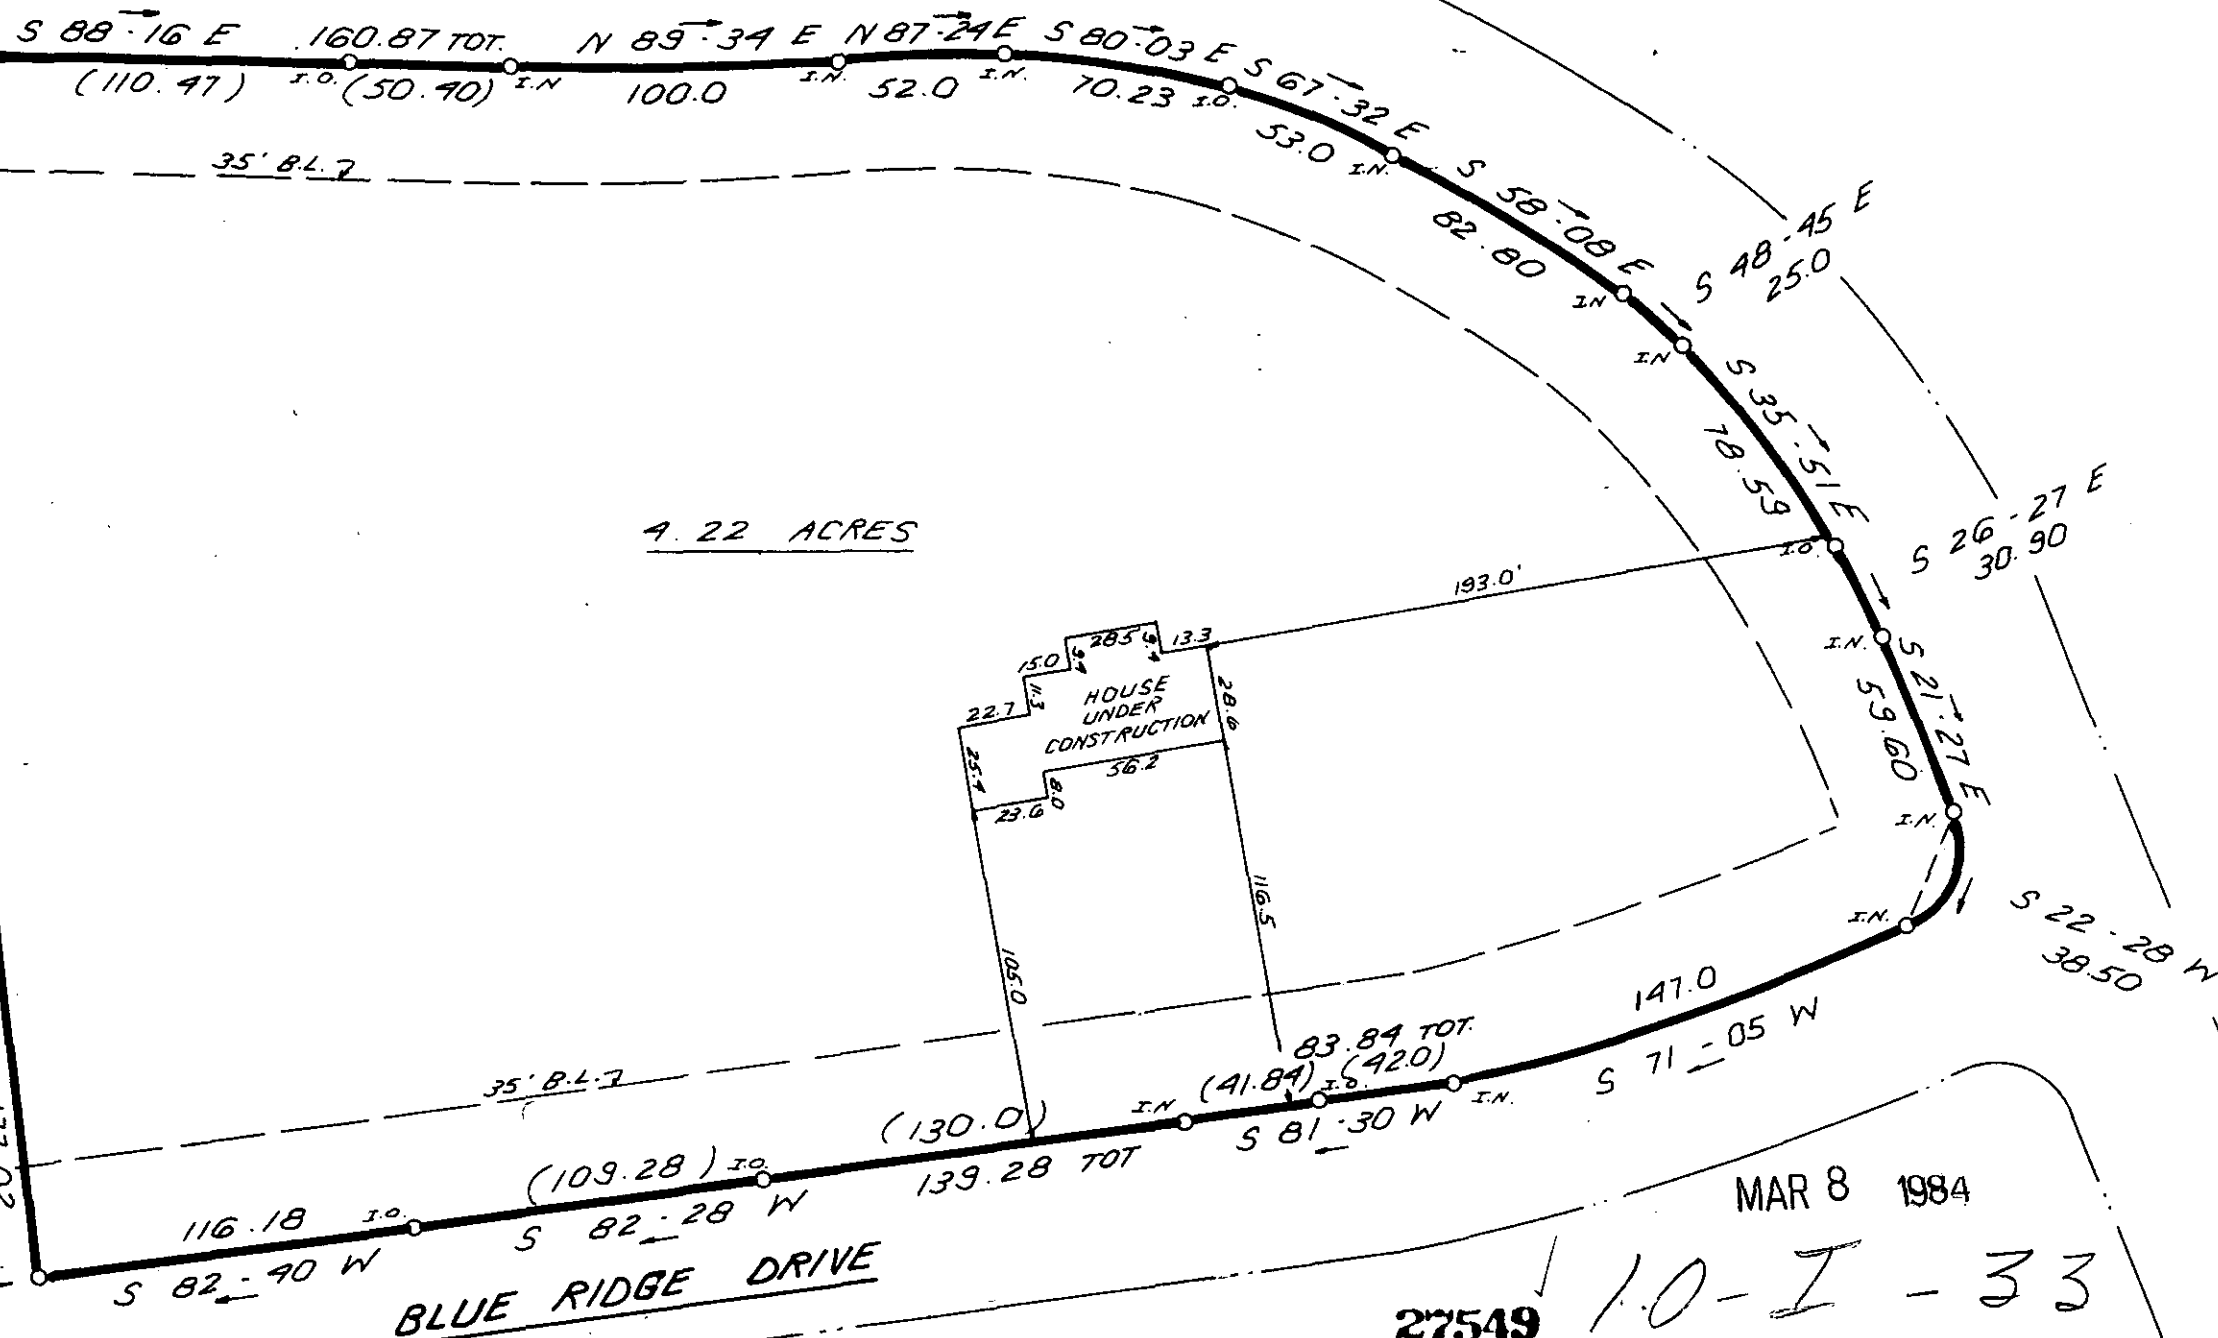


ENDREE HEIGHTS

MAR 8 1984

27549 10-I-33

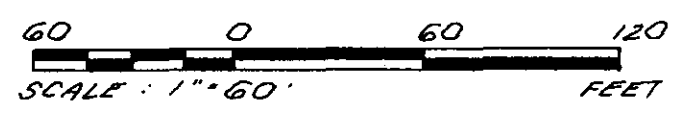

THIS IS TO CERTIFY THAT THE PROPERTY SHOWN ON THIS PLAT WAS SURVEYED UNDER MY DIRECT SUPERVISION. PROPERTY LINES AND IMPROVEMENTS SHOWN ARE LOCATED CORRECTLY AND THAT NO VISIBLE ENCROACHMENTS EXIST UNLESS OTHERWISE SHOWN. THIS PROPERTY IS NOT LOCATED IN A DESIGNATED FLOOD HAZARD AREA.

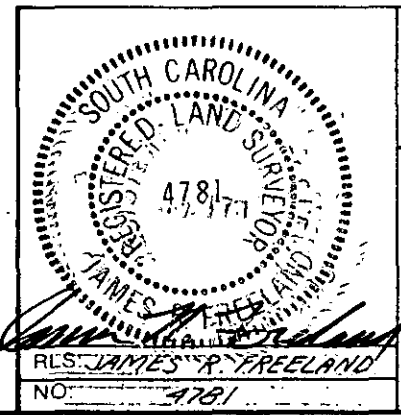

STATE OF SOUTH CAROLINA
GREENVILLE COUNTY

ENDREE HEIGHTS
 LOTS 52 - 59
 PROPERTY OF
 DONNIE RAY SORENSON
 MARCIA K. SORENSON

FREELAND & ASSOCIATES
 Engineers • Land Surveyors
 318 WEST STONE AVENUE.
 GREENVILLE, S.C.
 (803) 271-4924

PLAT BOOK	QQ-59 & 55
DEED BOOK	1160-417
TAX MAP	5011-1-52 THRU 59
PARTY CHIEF	L.T.
DRAWN	K.E.G.
DATE	MARCH 5, 1984
DWG. NO.	10,645

THE PRINT MACHINE, INC. N41289

MICROFILMED