


Note: This is Lot #15 Grand View Hills, Plat Book WWW - Page 52.

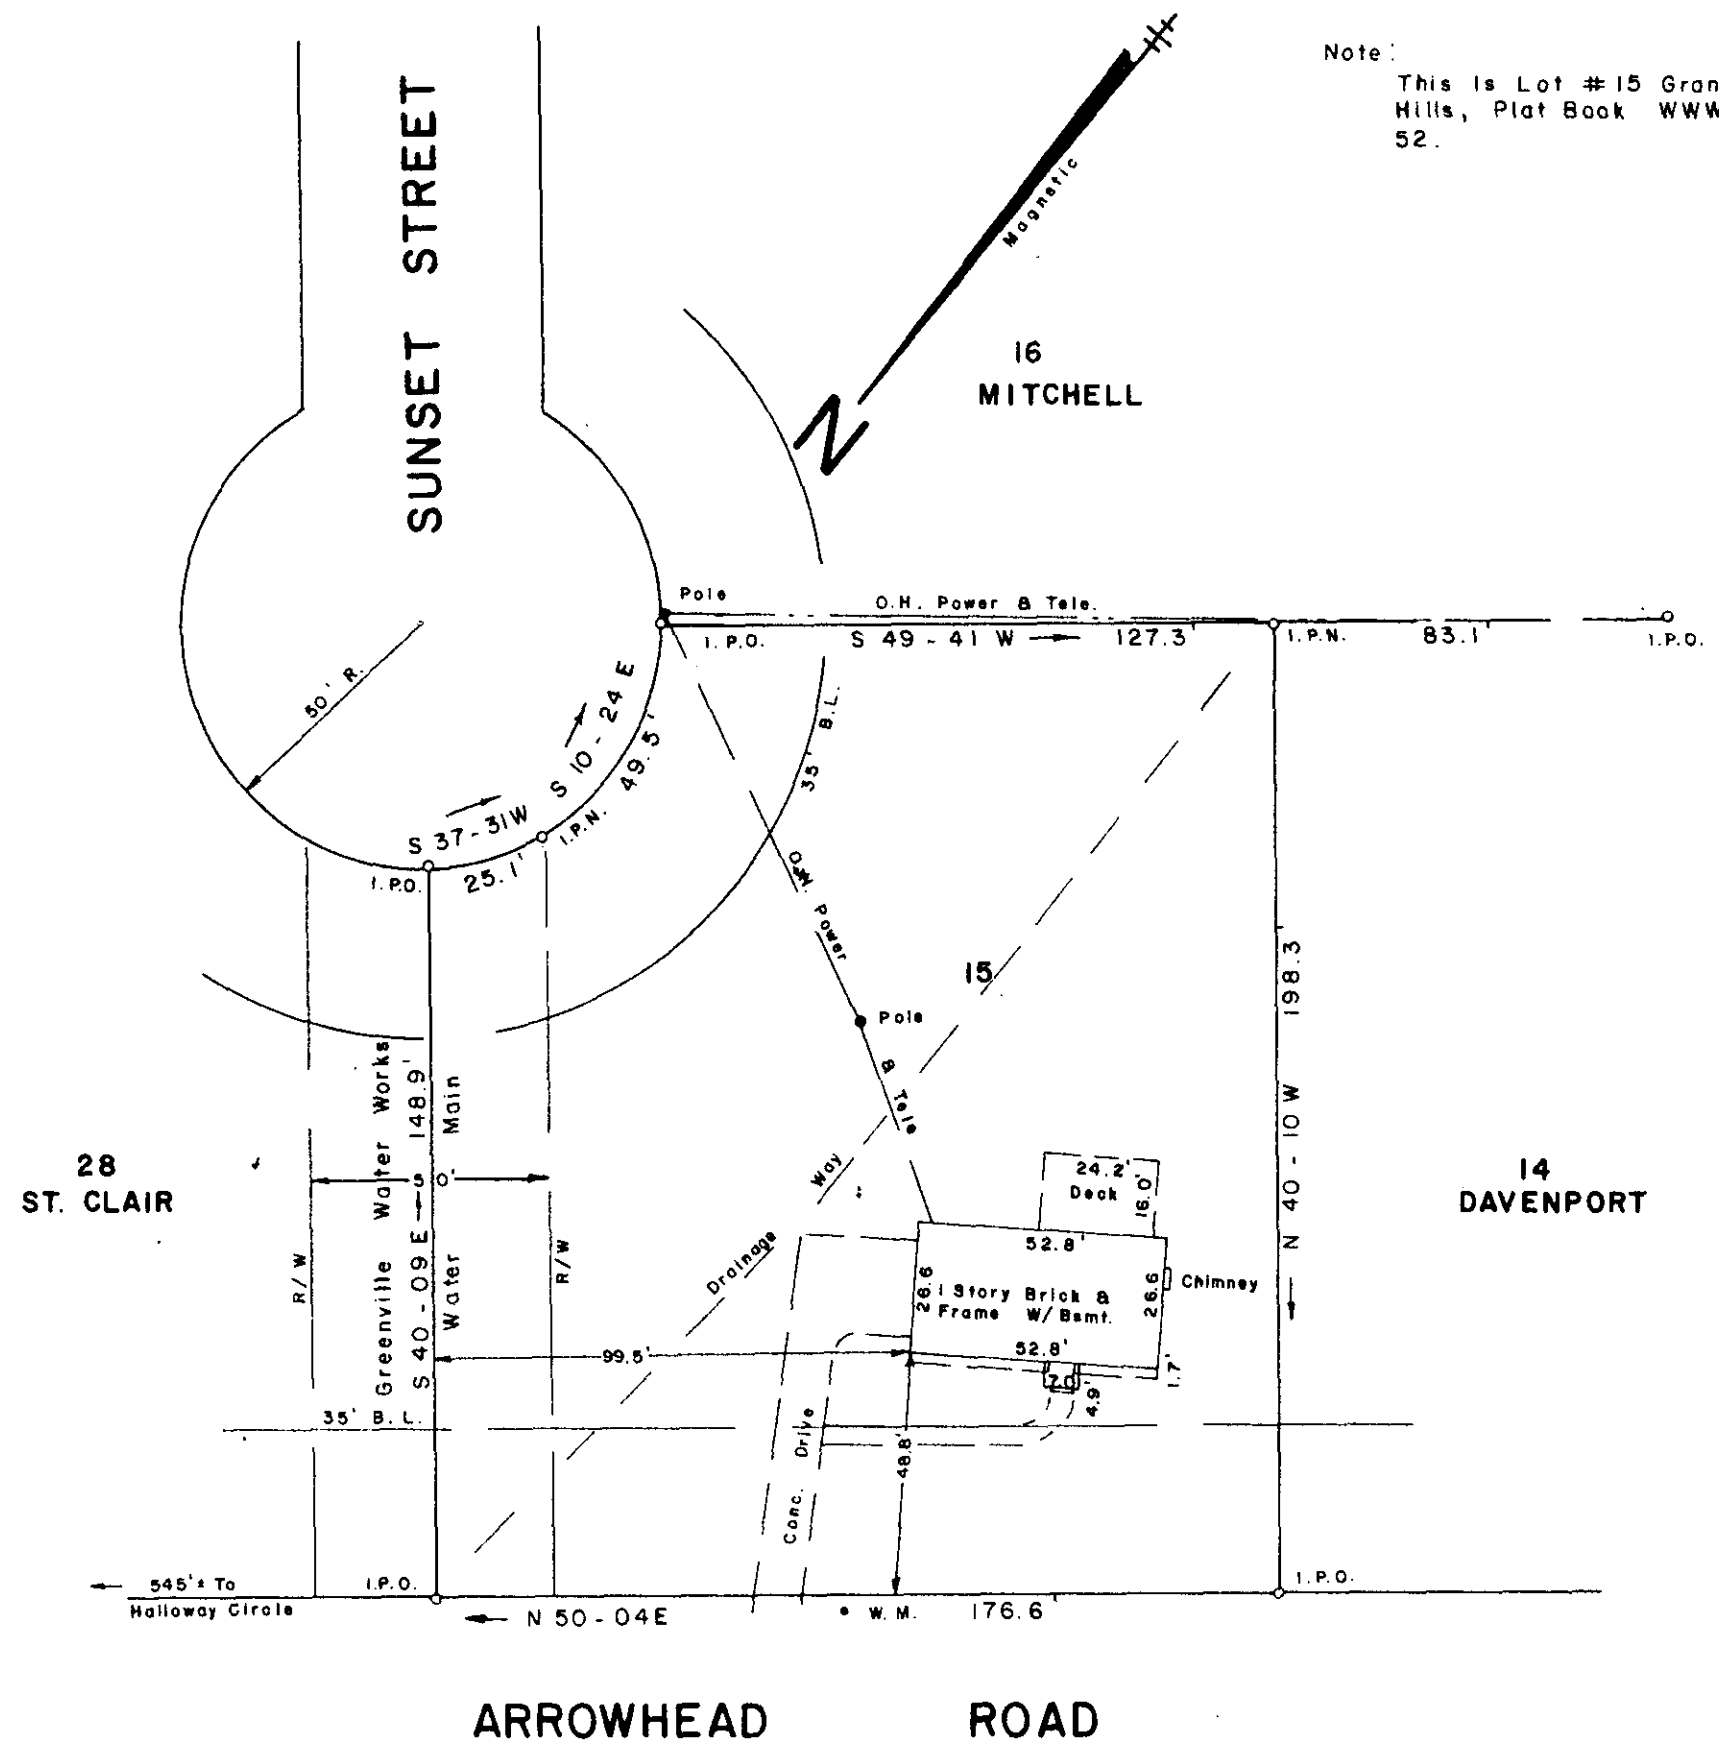

SURVEY FOR
JAMES R. WRIGHT
ANN G. WRIGHT
 NEAR GREENVILLE GREENVILLE COUNTY
 SOUTH CAROLINA

FILED
 GREENVILLE CO. S.C.
 MAR 23 3 25 PM '84
 DONNIE S. TANKERSLEY
 R.M.C.


MARCH 21, 1984

10-I-63


MAR 23 1984


To The Best Of My Knowledge This Structure Is Not In An Established Flood Zone.

29382


JEFFERY M. PLUMBLEE, INC.
 LAND SURVEYING
 P. O. BOX 788
 TRAVELERS REST. S. C. 29690 (803) 834-4428

I Hereby Certify That The Ratio Of Precision Of The Field Survey Is 1/5000 As Shown Hereon And The Area Was Determined By Computer.

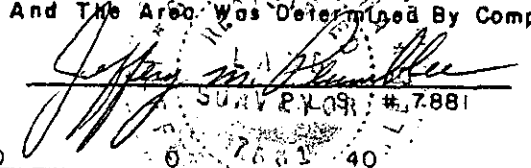
 SURVEYOR #7881

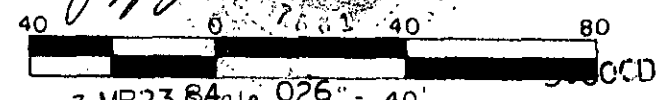

50 TO 3 MR23 84 Date 026" = 40'